

USE TYPEWRITER OR BALL POINT PEN-PRESS FIRMLY, PRINT CLEARLY.


WATER WELL RECORD
KSA 82a-1201-1215

Kansas Department of Health and Environment-Division of Environment
(Water well Contractors)
Topeka, Kansas 66620

Smith #1

1. Location of well: County Rice Fraction SE 1/4 NW 1/4 N 1/4 Section number 13 Township number T 19 S Range number R 10 W E/W

2. Distance and direction from nearest town or city: 3 mi SW Chase
Street address of well location if in city: 2 West Chase
3. Owner of well: Sterling Drilling Co
R.R. or street: Sterling Kansas
City, state, zip code: _____

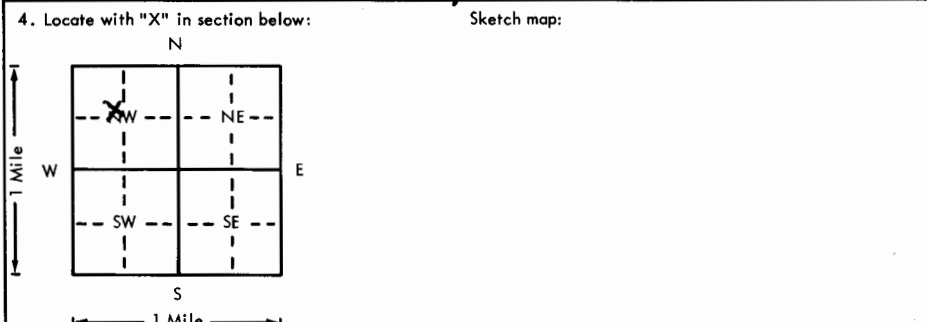

6. Bore hole dia. 8 in. Completion date _____
Well depth 100 ft. 4-14-77
7. Cable tool Rotary Driven Dug
 Hollow rod Jetted Bored Reverse rotary
8. Use: Domestic Public supply Industry
 Irrigation Air conditioning Stock
 Lawn Oil field water Other
9. Casing: Material Plastic Height: (Above or below) _____
Threaded Welded Surface 12 in.
RMP _____ PVC Weight 287 lbs./ft.
Dia. 5 in. to 100 ft. depth Wall Thickness: _____ inches or
Dia. _____ in. to _____ ft. depth gage Nq 200

5. Type and color of material

	From	To
<u>Clay</u>	<u>0</u>	<u>10</u>
<u>Sandy Clay</u>	<u>10</u>	<u>60</u>
<u>Sand</u>	<u>60</u>	<u>80</u>
<u>Gravel</u>	<u>80</u>	<u>100</u>

10. Screens: Manufacturer's name _____
Self made
Type Pre Dia. 5
Slot/gauze 3 Length 20
Set between 80 ft. and 100 ft.
_____ ft. and _____ ft.
Gravel pack? yes Size range of material 3/4 - 1/2
11. Static water level: _____ mo./day/yr.
30 ft. below land surface Date 4-14-77
12. Pumping level below land surfaces:
_____ ft. after _____ hrs. pumping _____ g.p.m.
_____ ft. after _____ hrs. pumping _____ g.p.m.
Estimated maximum yield _____ g.p.m.
13. Water sample submitted: _____ mo./day/yr.
 Yes No Date _____
14. Well head completion: _____
 Pitless adapter 12 Inches above grade
15. Well grouted? yes
With: _____ Neat cement Bentonite _____ Concrete
Depth: From 0 ft. to 10 ft.
16. Nearest source of possible contamination: _____ ft. _____ Direction _____ Type pure
Well disinfected upon completion? _____ Yes _____ No
17. Pump: Not installed
Manufacturer's name _____
Model number _____ HP _____ Volts _____
Length of drop pipe _____ ft. capacity _____ g.p.m.
Type:
 Submersible Turbine
 Jet Reciprocating
 Centrifugal Other

(Use a second sheet if needed)

18. Elevation: _____
19. Remarks: _____
20. Water well contractor's certification:
This well was drilled under my jurisdiction and this report is true to the best of my knowledge and belief.
Meyer Water Well
Business name _____ License No. _____
Address: St Bend Kans 142
Signed: A Meyer Date 4-14-77
Authorized representative