

USE TYPEWRITER OR BALL POINT PEN-PRESS FIRMLY, PRINT CLEARLY.


WATER WELL RECORD  
KSA 82a-1201-1215

Kansas Department of Health and Environment-Division of Environment (Water well Contractors) Topeka, Kansas 66620

*Browning #1*

1. Location of well: County *Rice* Fraction *SW 1/4 NE 1/4 NW 1/4* Section number *13* Township number *T 19 S S R 10 W E/W* Range number

2. Distance and direction from nearest town or city: *4 north* 3. Owner of well: *Duke Drilling Co*  
Street address of well location if in city: *1 3/4 west of Chase* R.R. or street: *Great Bend Kansas*  
City, state, zip code:

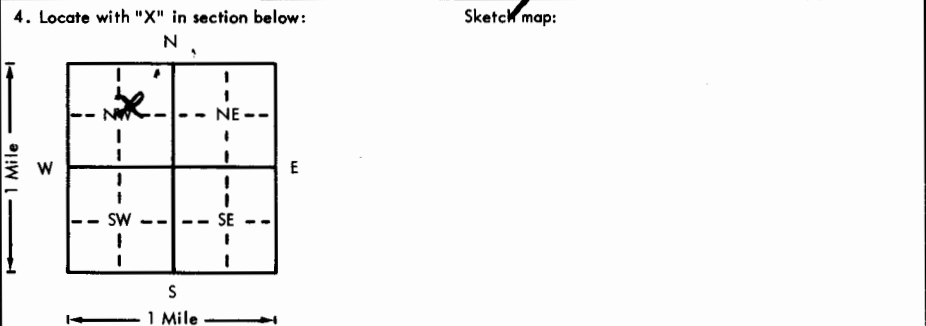

6. Bore hole dia. *4* in. Completion date *12-5-75*  
Well depth *95* ft.  
7.  Cable tool  Rotary  Driven  Dug  
 Hollow rod  Jetted  Bored  Reverse rotary  
8. Use:  Domestic  Public supply  Industry  
 Irrigation  Air conditioning  Stock  
 Lawn  Oil field water  Other  
9. Casing: Material *Plastic* Height: *Above* or below  
Threaded  Welded  Surface *12* in.  
RMP  PVC  Weight *183 1000*  
Dia *4* in. to *95* ft. depth Wall Thickness: inches or  
Dia.  in. to  ft. depth gauge No. *200*

5. Type and color of material

	From	To
<i>Clay</i>	<i>0</i>	<i>45</i>
<i>Sand</i>	<i>45</i>	<i>50</i>
<i>Clay</i>	<i>50</i>	<i>65</i>
<i>yellow sand Rich</i>	<i>65</i>	<i>95</i>

10. Screen: Manufacturer's name *Peerless Plastic*  
Type *PVC* Dia. *4*  
Slot/gauze *5* Length *20*  
Set between *25* ft. and *95* ft.  
ft. and  ft.  
Gravel pack?  size range of material *5-1/4*  
11. Static water level: *17* ft. below land surface Date *12-5-75* mo./day/yr.  
12. Pumping level below land surfaces:  
\_\_\_\_ ft. after \_\_\_\_ hrs. pumping \_\_\_\_ g.p.m.  
\_\_\_\_ ft. after \_\_\_\_ hrs. pumping \_\_\_\_ g.p.m.  
Estimated maximum yield \_\_\_\_ g.p.m.  
13. Water sample submitted: \_\_\_\_ mo./day/yr.  
Yes  No  Date \_\_\_\_  
14. Well head completion:  
\_\_\_\_ Pitless adapter \_\_\_\_ Inches above grade  
15. Well grouted? *yes*  
With: \_\_\_\_ Neat Cement  Bentonite \_\_\_\_ Concrete  
Depth: From *0* ft. to *10* ft.  
16. Nearest source of possible contamination:  
ft. \_\_\_\_ Direction \_\_\_\_ Type \_\_\_\_  
Well disinfected upon completion? \_\_\_\_ Yes \_\_\_\_ No  
17. Pump:  Not installed  
Manufacturer's name \_\_\_\_  
Model number \_\_\_\_ HP \_\_\_\_ Volts \_\_\_\_  
Length of drop pipe \_\_\_\_ ft. capacity \_\_\_\_ g.p.m.  
Type:  
 Submersible  Turbine  
 Jet  Reciprocating  
 Centrifugal  Other

18. Elevation: Topography:  Hill  Slope  Upland  Valley  
19. Remarks:

20. Water well contractor's certification:  
This well was drilled under my jurisdiction and this report is true to the best of my knowledge and belief.  
Business name *Myers Water Well* License No. *143*  
Address *Great Bend KS*  
Signed *Clyde A. Myers* Date *12-5-75*  
Authorized representative

T 19 S R 10 E Sec 13 SW 1/4 NW 1/4