

SOUTHERN

WATER WELL RECORD Form WWC-5 KSA 82a-1212


1 LOCATION OF WATER WELL: County: RICE	Fraction SW 1/4 SW 1/4 NE 1/4	Section Number 14	Township Number T 19 S	Range Number R 10 E
--	---	-----------------------------	----------------------------------	-------------------------------

Distance and direction from nearest town or city street address of well if located within city?

CHASE 2 1/4 N 2 W 1/2 N WESTSIDE

2 WATER WELL OWNER: RR#, St. Address, Box # : City, State, ZIP Code	DUKE DRILLING CO INC. 620 HUBBARD BOX 823 GREAT BEND, KS 67530	JW SOUTHERN ELLINGWOOD, KS	Board of Agriculture, Division of Water Resources Application Number: T 83-60
---	---	---	---

3 LOCATE WELL'S LOCATION WITH AN "X" IN SECTION BOX:

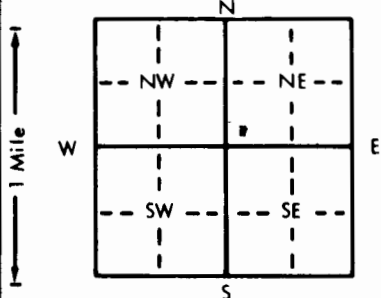

4 DEPTH OF COMPLETED WELL: 60 ft. ELEVATION:
Depth(s) Groundwater Encountered 1. 27 ft. 2. 40 ft. 3. _____ ft.
WELL'S STATIC WATER LEVEL 12 ft. below land surface measured on mo/day/yr 2-4-83
Pump test data: Well water was _____ ft. after _____ hours pumping _____ gpm
Est. Yield _____ gpm: Well water was _____ ft. after _____ hours pumping _____ gpm
Bore Hole Diameter 7 7/8 in. to 60 ft., and _____ in. to _____ ft.
WELL WATER TO BE USED AS:
5 Public water supply 8 Air conditioning 11 Injection well
1 Domestic 3 Feedlot 6 Oil field water supply 9 Dewatering 12 Other (Specify below)
2 Irrigation 4 Industrial 7 Lawn and garden only 10 Observation well
Was a chemical/bacteriological sample submitted to Department? Yes _____ No _____; If yes, mo/day/yr sample was submitted _____
Water Well Disinfected? Yes _____ No _____

5 TYPE OF BLANK CASING USED:	5 Wrought iron	8 Concrete tile	CASING JOINTS: Glued <input checked="" type="checkbox"/> Clamped _____
1 Steel	3 RMP (SR)	6 Asbestos-Cement	9 Other (specify below) _____
2 PVC	4 ABS	7 Fiberglass	_____
Blank casing diameter 5 in. to 40 ft., Dia _____ in. to _____ ft., Dia _____ in. to _____ ft.			
Casing height above land surface 12 in., weight _____ lbs./ft. Wall thickness or gauge No. 2-14			

TYPE OF SCREEN OR PERFORATION MATERIAL:	7 PVC	10 Asbestos-cement
1 Steel	3 Stainless steel	5 Fiberglass
2 Brass	4 Galvanized steel	6 Concrete tile
8 RMP (SR)	9 ABS	12 None used (open hole)

SCREEN OR PERFORATION OPENINGS ARE: 48	5 Gauzed wrapped	8 Saw cut	11 None (open hole)
1 Continuous slot	3 Mill slot	6 Wire wrapped	9 Drilled holes
2 Louvered shutter	4 Key punched	7 Torch cut	10 Other (specify) _____

SCREEN-PERFORATED INTERVALS: From 40 ft. to 60 ft., From _____ ft. to _____ ft.
GRAVEL PACK INTERVALS: From 30 ft. to 60 ft., From _____ ft. to _____ ft.

6 GROUT MATERIAL:	1 Neat cement	2 Cement grout	3 Bentonite	4 Other _____
Grout Intervals: From 0 ft. to 10 ft., From _____ ft. to _____ ft.				
What is the nearest source of possible contamination: NONE	10 Livestock pens	14 Abandoned water well		
1 Septic tank	4 Lateral lines	7 Pit privy	11 Fuel storage	15 Oil well/Gas well
2 Sewer lines	5 Cess pool	8 Sewage lagoon	12 Fertilizer storage	16 Other (specify below)
3 Watertight sewer lines	6 Seepage pit	9 Feedyard	13 Insecticide storage	
Direction from well? _____			How many feet? _____	

FROM	TO	LITHOLOGIC LOG	FROM	TO	LITHOLOGIC LOG
0	5	SOIL			
5	25	CLAY			
25	40	SANDY CLAY			
40	60	GRAVEL			

7 CONTRACTOR'S OR LANDOWNER'S CERTIFICATION: This water well was (1) constructed, (2) reconstructed, or (3) plugged under my jurisdiction and was completed on (mo/day/year) **2-4-83** and this record is true to the best of my knowledge and belief. Kansas Water Well Contractor's License No. **389** This Water Well Record was completed on (mo/day/yr) **2-16-83** under the business name of **REISER WATER WELL SERVICE INC.** by (signature) *Rudolph Reiser*

INSTRUCTIONS: Use typewriter or ball point pen, PLEASE PRESS FIRMLY and PRINT clearly. Please fill in blanks, underline or circle the correct answers. Send top three copies to Kansas Department of Health and Environment, Division of Environment, Environmental Geology Section, Topeka, KS 66620. Send one to WATER WELL OWNER and retain one for your records.