

USE TYPEWRITER OR BALL POINT PEN-PRESS FIRMLY, PRINT CLEARLY.

T R EW sec 1/4 1/4 1/4 No.

WATER WELL RECORD
KSA 82a-1201-1215


Kansas State Dept. Of Health
(Water Well Contractors)
Forbes-Bldg. 740
Topeka, Kansas 66620

1 Location of well:	County <i>Rice</i>	Township name	Fraction <i>NE 1/4 SE 1/4</i>	Section number <i>15</i>	Town number <i>19</i>	Range number <i>10</i>
---------------------	-----------------------	---------------	----------------------------------	-----------------------------	--------------------------	---------------------------


Street address of well location if in city:

3 Owner of well: *H-30 Building Co.*

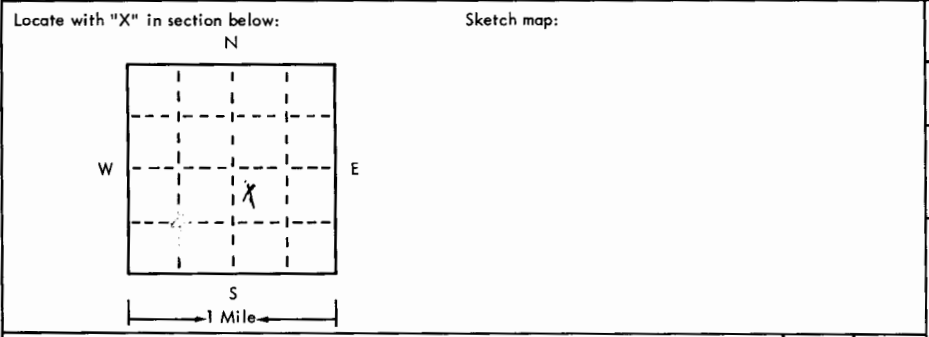

4 Well depth: *85* ft. Date of completion *1-7-75*
Well diameter *4 1/2* in.

5 Cable tool Rotary Driven Dug
 Hollow rod Jetted Bored Reverse rotary

6 Use: Domestic Public supply Industry
 Irrigation Air conditioning Commercial
 Test well

7 Casing: Material *Alc.* Height: above/below
Threaded Welded Surface *12* in.
Diam. Weight *60* lbs./ft.
4 in. to *27* ft. depth Drive shoe? Yes No
— in. to — ft. depth

2	Type and color of material	From	To
	<i>Top soil</i>	<i>0</i>	<i>1</i>
	<i>Brown clay</i>	<i>1</i>	<i>16</i>
	<i>Greenish-gray clay</i>	<i>17</i>	<i>28</i>
	<i>Sandy Brown clay</i>	<i>28</i>	<i>30</i>
	<i>Blue-gray clay</i>	<i>30</i>	<i>38</i>
	<i>Sandy brown clay</i>	<i>38</i>	<i>42</i>
	<i>Red-brown + gray clay w/ sand mixed</i>	<i>42</i>	<i>47</i>
	<i>Sand + gravel, clean, coarse, loose</i>	<i>47</i>	<i>83</i>
	<i>Brown clay</i>	<i>83</i>	<i>85</i>

(use a second sheet if needed)

8 Screen:
Manufacturer *R. & S.*
Type *perc.* Dia. *4 1/2*
Slot/gauze *1/16* Length *20*
Set between *63* ft. and *83* ft. *20*
Fittings:
Gravel pack Yes No Size range of material *1/8 - 3/16 - 1/4*

9 Static water level:
16 ft. below land surface Date *1-7-75*

10 Pumping level below land surfaces:
19 ft. after *24* hrs. pumping *25* g.p.m.
— ft. after — hrs. pumping — g.p.m.
Estimated maximum yield *300* g.p.m.

11 Water sample submitted:
 Yes No Date —

12 Well head completion:
 Pitless adapter Inches above grade

13 Well grouted? Yes No
 Neat cement Bentonite —
Depth: From *0* ft. to *10* ft.

14 Nearest source of possible contamination:
ft. *150* Direction *NE* Type *city well*
Well disinfected upon completion? Yes No

15 Pump: Not installed
Manufacturer's name —
Model number — HP — Volts —
Length of drop pipe — ft. capacity — g.m.p.
Type:
 Submersible Turbine
 Jet Reciprocating
 Centrifugal Other

16 Remarks: elevation

Topography:
 Hill
 Slope
 Upland
 Valley

17 Water well contractor's certification:
This well was drilled under my jurisdiction and this report is true to the best of my knowledge and belief.
Rosemary Sennis
Business name License No. *134*
Signed *Frederick Sennis* Date *1-8-75*
Authorized representative