


CAMPBELL

1 LOCATION OF WATER WELL: Fraction NE 1/4 SW 1/4 SW 1/4 Section Number 25 Township Number T 19 S Range Number R 10 E  
 County: RICE

Distance and direction from nearest town or city street address of well if located within city?  
CHASE 1/2 N 1 3/4 W NORTHSIDE.

2 WATER WELL OWNER: D. R. LAUCK OIL CO. INC. CAMPBELL, CHASE, KS  
 RR#, St. Address, Box #: 221 S. BROADWAY SUITE 400  
 City, State, ZIP Code: WICHITA KS 67202  
 Board of Agriculture, Division of Water Resources  
 Application Number: T84-801

3 LOCATE WELL'S LOCATION WITH AN "X" IN SECTION BOX:

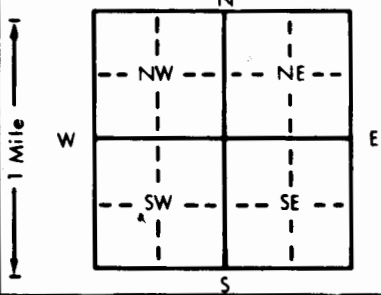

4 DEPTH OF COMPLETED WELL: 75 ft. ELEVATION: .....

Depth(s) Groundwater Encountered 1. 45 ft. 2. .... ft. 3. .... ft.

WELL'S STATIC WATER LEVEL 1.2 ft. below land surface measured on mo/day/yr 10-27-84

Pump test data: Well water was - ft. after ..... hours pumping ..... gpm

Est. Yield ..... gpm Well water was - ft. after ..... hours pumping ..... gpm

Bore Hole Diameter: 7 7/8 in. to 7 5/8 in. and ..... in. to ..... in.

WELL WATER TO BE USED AS: 5 Public water supply 8 Air conditioning 11 Injection well

1 Domestic 3 Feedlot 6 Oil field water supply 9 Dewatering 12 Other (Specify below)

2 Irrigation 4 Industrial 7 Lawn and garden only 10 Observation well

Was a chemical/bacteriological sample submitted to Department? Yes.....No.....; If yes, mo/day/yr sample was submitted

Water Well Disinfected? Yes No

5 TYPE OF BLANK CASING USED: 5 Wrought iron 8 Concrete tile CASING JOINTS: Glued XX Clamped .....

1 Steel 3 RMP (SR) 6 Asbestos-Cement 9 Other (specify below) Welded .....

2 PVC 4 ABS 7 Fiberglass Threaded .....

Blank casing diameter 5 in. to 5 5/8 ft. Dia. .... in. to ..... ft. Dia. .... in. to ..... ft.

Casing height above land surface 1.2 in., weight 2-65 lbs./ft. Wall thickness or gauge No. 2-14

TYPE OF SCREEN OR PERFORATION MATERIAL: 7 PVC 10 Asbestos-cement

1 Steel 3 Stainless steel 5 Fiberglass 8 RMP (SR) 11 Other (specify) .....

2 Brass 4 Galvanized steel 6 Concrete tile 9 ABS 12 None used (open hole)

SCREEN OR PERFORATION OPENINGS ARE: 1/8 5 Gauzed wrapped 8 Saw cut 11 None (open hole)

1 Continuous slot 3 Mill slot 6 Wire wrapped 9 Drilled holes

2 Louvered shutter 4 Key punched 7 Torch cut 10 Other (specify) .....

SCREEN-PERFORATED INTERVALS: From 55 ft. to 75 ft., From ..... ft. to ..... ft.

GRAVEL PACK INTERVALS: From 4.5 ft. to 7.5 ft., From ..... ft. to ..... ft.

6 GROUT MATERIAL: 1 Neat cement 2 Cement grout 3 Bentonite 4 Other .....

Grout Intervals: From 0 ft. to 10 ft., From ..... ft. to ..... ft., From ..... ft. to ..... ft.

What is the nearest source of possible contamination: NONE 10 Livestock pens 14 Abandoned water well

1 Septic tank 4 Lateral lines 7 Pit privy 11 Fuel storage 15 Oil well/Gas well

2 Sewer lines 5 Cess pool 8 Sewage lagoon 12 Fertilizer storage 16 Other (specify below)

3 Watertight sewer lines 6 Seepage pit 9 Feedyard 13 Insecticide storage .....

Direction from well? How many feet?

FROM	TO	LITHOLOGIC LOG	FROM	TO	LITHOLOGIC LOG
0	30	CLAY			
30	32	SAND			
32	45	CLAY			
45	75	GRAVEL			

7 CONTRACTOR'S OR LANDOWNER'S CERTIFICATION: This water well was (1) constructed, (2) reconstructed, or (3) plugged under my jurisdiction and was

completed on (mo/day/year) 10-27-84 and this record is true to the best of my knowledge and belief. Kansas

Water Well Contractor's License No. 389 This Water Well Record was completed on (mo/day/yr) 11-8-84

under the business name of RELSET WATER WELL SERV. INC. by (signature) Rudolph J. Reese

INSTRUCTIONS: Use typewriter or ball point pen, PLEASE PRESS FIRMLY and PRINT clearly. Please fill in blanks, underline or circle the correct answers. Send top three copies to Kansas Department of Health and Environment, Division of Environment, Environmental Geology Section, Topeka, KS 66620. Send one to WATER WELL OWNER and retain one for your records.