


HEINE #1

1 LOCATION OF WATER WELL: Fraction NE 1/4 NW 1/4 SE 1/4 Section Number 25 Township Number T 19 S Range Number R 10 E (W)

Distance and direction from nearest town or city street address of well if located within city? Chase 1/4 NORTH, WEST, 1/2 NORTH, WEST INTO WATER WELL OWNER: Woodman-Iannitti Drilling Co. M M HEINE, CHASE, KS Board of Agriculture, Division of Water Resources RR#, St. Address, Box #: 1022 UNION CENTER Bldg Application Number: T85-604 City, State, ZIP Code: Wichita, KS. 67202

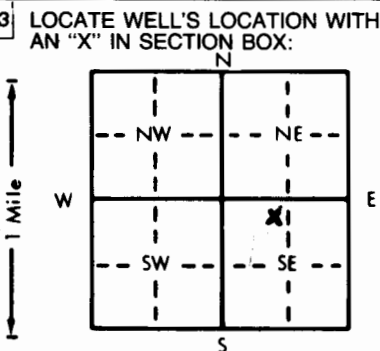

3 LOCATE WELL'S LOCATION WITH AN 'X' IN SECTION BOX: 4 DEPTH OF COMPLETED WELL: 60 ft. ELEVATION: 30 ft. WELL'S STATIC WATER LEVEL: 10 ft. below land surface measured on mo/day/yr 6-27-85 Pump test data: Well water was ... ft. after ... hours pumping ... gpm Est. Yield ... gpm Well water was ... ft. after ... hours pumping ... gpm Bore Hole Diameter: 7 7/8 in. to 60 ft., and ... in. to ... ft. WELL WATER TO BE USED AS: 5 Public water supply 8 Air conditioning 11 Injection well 1 Domestic 3 Feedlot 6 Oil field water supply 9 Dewatering 12 Other (Specify below) 2 Irrigation 4 Industrial 7 Lawn and garden only 10 Observation well Was a chemical/bacteriological sample submitted to Department? Yes ... No ... X ...; If yes, mo/day/yr sample was submitted Water Well Disinfected? Yes No X

5 TYPE OF BLANK CASING USED: 1 Steel 3 RMP (SR) 5 Wrought iron 8 Concrete tile CASING JOINTS: Glued X Clamped Welded Threaded 2 PVC 4 ABS 7 Fiberglass 9 Other (specify below) Blank casing diameter: 5 in. to 40 ft., Dia. 12 in., weight 2.65 lbs./ft. Wall thickness or gauge No. 214 TYPE OF SCREEN OR PERFORATION MATERIAL: 1 Steel 3 Stainless steel 5 Fiberglass 8 RMP (SR) 10 Asbestos-cement 2 Brass 4 Galvanized steel 6 Concrete tile 9 ABS 12 None used (open hole) SCREEN OR PERFORATION OPENINGS ARE: 1 Continuous slot 3 Mill slot 5 Gauzed wrapped 8 Saw cut 11 None (open hole) 2 Louvered shutter 4 Key punched 6 Wire wrapped 9 Drilled holes 7 Torch cut 10 Other (specify) SCREEN-PERFORATED INTERVALS: From 40 ft. to 60 ft. GRAVEL PACK INTERVALS: From 30 ft. to 60 ft.

6 GROUT MATERIAL: 1 Neat cement 2 Cement grout 3 Bentonite 4 Other Grout Intervals: From 0 ft. to 10 ft., From ... ft. to ... ft. What is the nearest source of possible contamination: NONE 10 Livestock pens 14 Abandoned water well 1 Septic tank 4 Lateral lines 7 Pit privy 11 Fuel storage 15 Oil well/Gas well 2 Sewer lines 5 Cess pool 8 Sewage lagoon 12 Fertilizer storage 16 Other (specify below) 3 Watertight sewer lines 6 Seepage pit 9 Feedyard 13 Insecticide storage

Direction from well? How many feet? FROM TO LITHOLOGIC LOG FROM TO LITHOLOGIC LOG

0	2	Top Soil			
2	30	CLAY			
30	58	GRAVEL			
58	60	CLAY			

7 CONTRACTOR'S OR LANDOWNER'S CERTIFICATION: This water well was (1) constructed (2) reconstructed, or (3) plugged under my jurisdiction and was completed on (mo/day/year) 6-27-85 and this record is true to the best of my knowledge and belief. Kansas Water Well Contractor's License No. 389 This Water Well Record was completed on (mo/day/yr) 7-1-85 under the business name of Reiser Water Well Service by (signature) Rudolph Meiser INSTRUCTIONS: Use typewriter or ball point pen, PLEASE PRESS FIRMLY and PRINT clearly. Please fill in blanks, underline or circle the correct answers. Send top three copies to Kansas Department of Health and Environment, Division of Environment, Environmental Geology Section, Topeka, KS 66620. Send one to WATER WELL OWNER and retain one for your records.