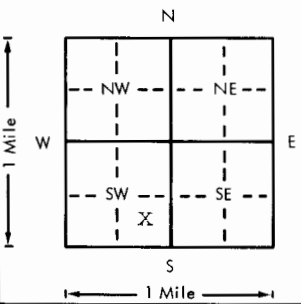


USE TYPEWRITER OR BALL POINT PEN-PRESS FIRMLY, PRINT CLEARLY.

WATER WELL RECORD
KSA 82a-1201-1215

Kansas Department of Health and Environment-Division of Environment
(Water well Contractors)
Topeka, Kansas 66620

1. Location of well:		County <u>Rice</u> <u>Barton</u>	Fraction <u>C 1/4 SE 1/4 SW/4</u>	Section number <u>K#730</u>	Township number <u>T 19 S</u>	Range number <u>R 10 E</u>
2. Distance and direction from nearest town or city: <u>5-E 1-N 2-E from Ellinwood, Ks. North side</u> Street address of well location if in city:				3. Owner of well: <u>Richardson Real Estate</u> R.R. or street: <u>5 North Main</u> City, state, zip code: <u>Ellinwood, Kansas 67526</u>		
4. Locate with "X" in section below: Sketch map: 			6. Bore hole dia. <u>10</u> in. Completion date _____ Well depth <u>50</u> ft. <u>4-13-79</u>			
5. Type and color of material			From	To	7. <input type="checkbox"/> Cable tool <input checked="" type="checkbox"/> Rotary <input type="checkbox"/> Driven <input type="checkbox"/> Dug <input type="checkbox"/> Hollow rod <input type="checkbox"/> Jetted <input type="checkbox"/> Bored <input type="checkbox"/> Reverse rotary	
top soil			0	2	8. Use: <input type="checkbox"/> Domestic <input type="checkbox"/> Public supply <input type="checkbox"/> Industry <input type="checkbox"/> Irrigation <input type="checkbox"/> Air conditioning <input checked="" type="checkbox"/> Stock <input type="checkbox"/> Lawn <input type="checkbox"/> Oil field water <input type="checkbox"/> Other	
clay			2	12	9. Casing: Material <u>PVC</u> Height: Above or below Threaded _____ Welded _____ Surface <u>18</u> in. RMP _____ PVC <input checked="" type="checkbox"/> Weight _____ lbs./ft. Dia. <u>4</u> in. to <u>50</u> ft. depth Wall Thickness: inches or Dia. _____ in. to _____ ft. depth gauge No. <u>237</u>	
sandy gray clay			12	29	10. Screen: Manufacturer's name _____ <u>CertainTeed</u> Type <u>PVC</u> Dia. _____ Slot/gauge <u>1/16</u> Length <u>20</u> Set between _____ ft. and _____ ft. _____ ft. and _____ ft. Gravel pack? <input checked="" type="checkbox"/> Size range of material <u>3/4 3/8</u>	
fine sand & gravel			29	36	11. Static water level: _____ mo./day/yr. <u>16</u> ft. below land surface Date <u>4-13-79</u>	
med. sand & gravel			36	50	12. Pumping level below land surfaces: <u>na</u> _____ ft. after _____ hrs. pumping _____ g.p.m. _____ ft. after _____ hrs. pumping _____ g.p.m. Estimated maximum yield _____ g.p.m.	
					13. Water sample submitted: _____ mo./day/yr. <input checked="" type="checkbox"/> Yes <input type="checkbox"/> No Date <u>4-13-79</u>	
					14. Well head completion: <input type="checkbox"/> Pitless adapter _____ Inches above grade	
					15. Well grouted? <input checked="" type="checkbox"/> With: <input checked="" type="checkbox"/> Neat cement <input type="checkbox"/> Bentonite <input type="checkbox"/> Concrete Depth: From _____ ft. to <u>10</u> ft.	
					16. Nearest source of possible contamination: ft. <u>200</u> Direction <u>south</u> Type <u>septic</u> Well disinfected upon completion? <input checked="" type="checkbox"/> Yes <input type="checkbox"/> No	
					17. Pump: <input checked="" type="checkbox"/> Not installed Manufacturer's name _____ Model number _____ HP _____ Volts _____ Length of drop pipe _____ ft. capacity _____ g.p.m. Type: <input type="checkbox"/> Submersible <input type="checkbox"/> Turbine <input type="checkbox"/> Jet <input type="checkbox"/> Reciprocating <input type="checkbox"/> Centrifugal <input type="checkbox"/> Other	
(Use a second sheet if needed)						
18. Elevation:		19. Remarks:				
Topography: <input type="checkbox"/> Hill <input type="checkbox"/> Slope <input type="checkbox"/> Upland <input checked="" type="checkbox"/> Valley						
20. Water well contractor's certification: This well was drilled under my jurisdiction and this report is true to the best of my knowledge and belief.						19 100 30 CSE SW
Business name <u>Rosenkrantz-Bemis</u> License No. <u>134</u> Address <u>Great Bend, Kansas 67530</u>						
Signed <u>Judy Kilgore</u> Date <u>4-13-79</u> Authorized representative						