


1 LOCATION OF WATER WELL: Fraction Section Number Township Number Range Number
 County: Rice 159 C $\frac{1}{4}$ SW $\frac{1}{4}$ $\frac{1}{4}$ 33 T 19 S R 10W E/W

Distance and direction from nearest town or city street address of well if located within city?
5 W of Chase, Kansas

2 WATER WELL OWNER: John Neeland Lobo Drilling
 RR#, St. Address, Box #: Great Bend, Ks. 9 Box 823 Board of Agriculture, Division of Water Resources
 City, State, ZIP Code: 67530 Great Bend, Kansas 67530 Application Number: Unknown ✓

3 LOCATE WELL'S LOCATION WITH AN "X" IN SECTION BOX:

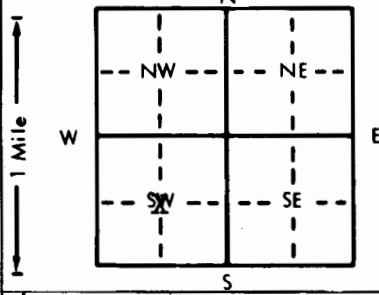

4 DEPTH OF COMPLETED WELL: 118 ft. ELEVATION: Unknown
 Depth(s) Groundwater Encountered 1. 40 ft. 2. . ft. 3. . ft.
 WELL'S STATIC WATER LEVEL: 40 ft. below land surface measured on mo/day/yr 2/13/85
 Pump test data: Well water was . ft. after . hours pumping . gpm
 Est. Yield 60 gpm: Well water was . ft. after . hours pumping . gpm
 Bore Hole Diameter: 8 in. to 118 ft., and . in. to . ft.
 WELL WATER TO BE USED AS:
 1 Domestic 3 Feedlot 6 Oil field water supply 9 Dewatering 12 Other (Specify below)
 2 Irrigation 4 Industrial 7 Lawn and garden only 10 Observation well
 Was a chemical/bacteriological sample submitted to Department? Yes No: If yes, mo/day/yr sample was submitted
 Water Well Disinfected? Yes No

5 TYPE OF BLANK CASING USED:
 1 Steel 3 RMP (SR) 5 Wrought iron 8 Concrete tile CASING JOINTS: Glued Clamped
 2 PVC 4 ABS 6 Asbestos-Cement 9 Other (specify below) Welded
 7 Fiberglass Threaded
 Blank casing diameter: 5 in. to 98 ft., Dia. in. to . ft., Dia. in. to . ft.
 Casing height above land surface: 12 in., weight 2.8 lbs./ft. Wall thickness or gauge No. Sch. 40

TYPE OF SCREEN OR PERFORATION MATERIAL:
 1 Steel 3 Stainless steel 5 Fiberglass 7 PVC 10 Asbestos-cement
 2 Brass 4 Galvanized steel 6 Concrete tile 8 RMP (SR) 11 Other (specify)
 9 ABS 12 None used (open hole)

SCREEN OR PERFORATION OPENINGS ARE:
 1 Continuous slot 3 Mill slot 5 Gauzed wrapped 8 Saw cut 11 None (open hole)
 2 Louvered shutter 4 Key punched 6 Wire wrapped 9 Drilled holes
 7 Torch cut 10 Other (specify)

SCREEN-PERFORATED INTERVALS: From 98 ft. to 118 ft., From . ft. to . ft.
 From . ft. to . ft., From . ft. to . ft.
 GRAVEL PACK INTERVALS: From 10 ft. to 118 ft., From . ft. to . ft.
 From ft. to ft., From ft. to ft.

6 GROUT MATERIAL: 1 Neat cement 2 Cement grout 3 Bentonite 4 Other
 Grout Intervals: From 0 ft. to 10 ft., From . ft. to . ft., From . ft. to . ft.
 What is the nearest source of possible contamination:
 1 Septic tank 4 Lateral lines 7 Pit privy 10 Livestock pens 14 Abandoned water well
 2 Sewer lines 5 Cess pool 8 Sewage lagoon 11 Fuel storage 15 Oil well/Gas well
 3 Watertight sewer lines 6 Seepage pit 9 Feedyard 12 Fertilizer storage 16 Other (specify below)
 13 Insecticide storage
 Direction from well? South How many feet? 60

FROM	TO	LITHOLOGIC LOG	FROM	TO	LITHOLOGIC LOG
0	50	<u>Clay</u>			
50	118	<u>Fine sand</u>			

7 CONTRACTOR'S OR LANDOWNER'S CERTIFICATION: This water well was (1) constructed, (2) reconstructed, or (3) plugged under my jurisdiction and was completed on (mo/day/year) 2/13/85 and this record is true to the best of my knowledge and belief, Kansas
 Water Well Contractor's License No. 186 This Water Well Record was completed on (mo/day/yr) 3/29/85
 under the business name of Kellys Water Well Service by (signature) [Signature]
 INSTRUCTIONS: Use typewriter or ball point pen, **PLEASE PRESS FIRMLY** and **PRINT** clearly. Please fill in blanks, underline or circle the correct answers. Send top three copies to Kansas Department of Health and Environment, Division of Environment, Environmental Geology Section, Topeka, KS 66620. Send one to WATER WELL OWNER and retain one for your records.