


USE TYPEWRITER OR BALL POINT PEN-PRESS FIRMLY, PRINT CLEARLY.

WATER WELL RECORD
KSA 82a-1201-1215

Kansas Department of Health and Environment-Division of Environment
(Water well Contractors)
Topeka, Kansas 66620

1. Location of well: County **Rice** Fraction **C 1/4 NE 1/4 SE 1/4** Section number **34** Township number **T 19 S R 10 E/W** Range number

2. Distance and direction from nearest town or city: **2-1/2 to 3/4-N of Chase, Kansas. W-side**
Street address of well location if in city:
3. Owner of well: **George Sieker**
R.R. or street: **RFD**
City, state, zip code: **Chase, Kansas 67524**

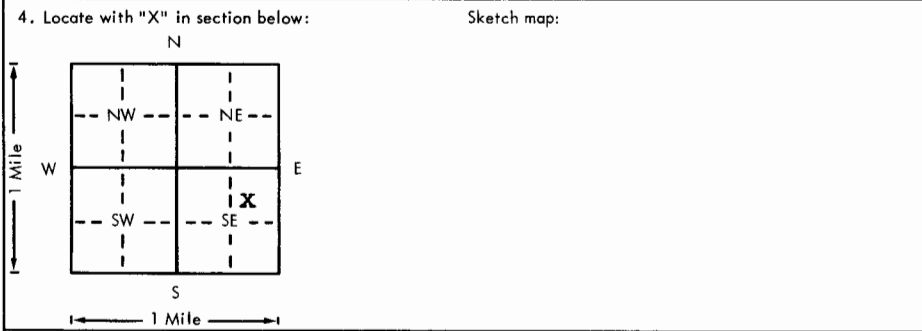

6. Bore hole dia. 11 in. Completion date _____
Well depth 50 ft. 5-24-78

7. Cable tool Rotary Driven Dug
 Hollow rod Jetted Bored Reverse rotary

8. Use: Domestic Public supply Industry
 Irrigation Air conditioning Stock
 Lawn Oil field water Other

9. Casing: Material pvc Height: Above or below _____
Threaded Welded Surface 3/8 24 in.
RMP 6 PVC Weight _____ lbs./ft.
Dia. 6 in. to 50 ft. depth Wall Thickness: inches or
Dia. _____ in. to _____ ft. depth gage No. 280

5. Type and color of material

	From	To
Black top soil	0	3
Brown clay	3	18
Black clay or mud	18	25
Fine sand	25	26
Brown & white clay	26	31
Medium to fine sand	31	53
(Use a second sheet if needed)		

10. Screen: Manufacturer's name CertainTeed
Type pvc Dia. 4
Slot 1/16 Length 10
Set between 40 ft. and 50 ft.
Set between _____ ft. and _____ ft.
Gravel pack? Size range of material 1/2 3/4 3/8

11. Static water level: _____ mo./day/yr.
11 ft. below land surface Date 5-24-78

12. Pumping level below land surfaces:
11 ft. after 1/2 hrs. pumping 60 g.p.m.
_____ ft. after _____ hrs. pumping _____ g.p.m.
Estimated maximum yield _____ g.p.m.

13. Water sample submitted: _____ mo./day/yr.
 Yes No Date 5-24-78

14. Well head completion:
 Pitless adapter _____ Inches above grade

15. Well grouted?
With: Neat cement Bentonite Concrete
Depth: From 0 ft. to 10 ft.

16. Nearest source of possible contamination:
ft. 200 Direction north Type oilwell
Well disinfected upon completion? HTH Yes No

17. Pump: Not installed
Manufacturer's name _____
Model number _____ HP _____ Volts _____
Length of drop pipe _____ ft. capacity _____ g.p.m.
Type:
 Submersible Turbine
 Jet Reciprocating
 Centrifugal Other

18. Elevation:
Topography:
 Hill
 Slope
 Upland
 Valley

19. Remarks:

20. Water well contractor's certification:
This well was drilled under my jurisdiction and this report is true to the best of my knowledge and belief.
Rosencrautz-Bemis 134
Business name License No.
Address Great Bend, Kansas 67530
Signed Sandy Kilgus Date 5-31-78
Authorized representative

T 19 S R 10 E W 34 C N E S E 1/4 1/4 1/4