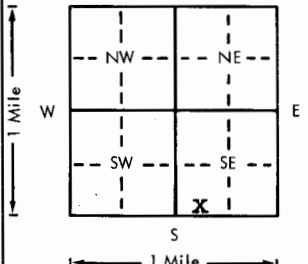


USE TYPEWRITER OR BALL POINT PEN-PRESS FIRMLY, PRINT CLEARLY.

WATER WELL RECORD  
KSA 82a-1201-1215

Kansas Department of Health and Environment-Division of Environment  
(Water well Contractors)  
Topeka, Kansas 66620

<input checked="" type="checkbox"/> Location of well:	County <b>Rice</b>	Fraction <b>SE SW 1/4 SW 1/4 SE 1/4</b>	Section number <b>35</b>	Township number <b>T 19 S R 10 E/W</b>	Range number <b>10</b>
2. Distance and direction from nearest town or city: <b>3/4 West of Raymond, ks. rd on Hyw 56. NS</b> Street address of well location if in city: <b>Chase</b>			3. Owner of well: <b>George SXX Sieker</b> R.R. or street: <b>none</b> City, state, zip code: <b>Chase, Kansas 67524</b>		
4. Locate with "X" in section below: N W E S 1 Mile			Sketch map: 		
5. Type and color of material			From	To	6. Bore hole dia. <u>11</u> in. Completion date _____ Well depth <u>60</u> ft. <u>7-10-78</u>
<b>Sandy tio soil</b>			0	2	7. <input type="checkbox"/> Cable tool <input checked="" type="checkbox"/> Rotary <input type="checkbox"/> Driven <input type="checkbox"/> Dug <input type="checkbox"/> Hollow rod <input type="checkbox"/> Jetted <input type="checkbox"/> Bored <input type="checkbox"/> Reverse rotary
<b>Fine Sand</b>			2	4	8. Use: <input type="checkbox"/> Domestic <input type="checkbox"/> Public supply <input type="checkbox"/> Industry <input type="checkbox"/> Irrigation <input type="checkbox"/> Air conditioning <input checked="" type="checkbox"/> Stock <input type="checkbox"/> Lawn <input type="checkbox"/> Oil field water <input type="checkbox"/> Other
<b>Sandy clay</b>			4	48	9. Casing: Material <u>pvc</u> Height: Above or below _____ Threaded _____ Welded _____ Surface <u>24</u> in. RMP _____ PVC <input checked="" type="checkbox"/> Weight _____ lbs./ft.
<b>Sand &amp; gravel - clay mixed</b>			48	52	Dia. <u>6</u> in. to _____ ft. depth; Wall Thickness: inches or Dia. <u>6</u> in. to <u>60</u> ft. depth; gage No. <u>.280</u>
<b>Fine sand &amp; clay</b>			52	93	<input checked="" type="checkbox"/> Screen: Manufacturer's name <u>CertainTeed</u>
<b>Clay</b>			93	108	Type <u>pvc</u> Dia. <u>6</u> Slot <u>1/16</u> Length <u>12</u> Set between <u>48</u> ft. and <u>60</u> ft. _____ ft. and _____ ft.
<b>Clay &amp; white rock</b>			108	110	Gravel pack? <input checked="" type="checkbox"/> Size range of material <u>3/4 3/8</u>
					11. Static water level: _____ mo./day/yr. <u>17</u> ft. below land surface Date <u>7-10-78</u>
					12. Pumping level below land surfaces: <u>na</u> _____ ft. after _____ hrs. pumping _____ g.p.m. _____ ft. after _____ hrs. pumping _____ g.p.m. Estimated maximum yield _____ g.p.m.
					13. Water sample submitted: _____ mo./day/yr. <input checked="" type="checkbox"/> Yes <input type="checkbox"/> No Date <u>7-10-78</u>
					14. Well head completion: <input type="checkbox"/> Pitless adapter _____ Inches above grade
					15. Well grouted? <input checked="" type="checkbox"/> With: <input checked="" type="checkbox"/> Neat cement <input type="checkbox"/> Bentonite <input type="checkbox"/> Concrete Depth: From <u>0</u> ft. to <u>10</u> ft.
					16. Nearest source of possible contamination: ft. <u>20</u> Direction <u>South</u> Type <u>silos</u> Well disinfected upon completion? <u>HTH</u> Yes <input type="checkbox"/> No <input type="checkbox"/>
					17. Pump: _____ Not installed Manufacturer's name _____ Model number _____ HP _____ Volts _____ Length of drop pipe _____ ft. capacity _____ g.p.m. Type: <input type="checkbox"/> Submersible <input type="checkbox"/> Turbine <input type="checkbox"/> Jet <input type="checkbox"/> Reciprocating <input type="checkbox"/> Centrifugal <input type="checkbox"/> Other
					(Use a second sheet if needed)
18. Elevation: <u>1748'</u> Topography: <input checked="" type="checkbox"/> Hill <input type="checkbox"/> Slope <input type="checkbox"/> Upland <input type="checkbox"/> Valley	19. Remarks:		20. Water well contractor's certification: This well was drilled under my jurisdiction and this report is true to the best of my knowledge and belief. <b>Rosencrantz-Bemis</b> <u>134</u> Business name License No. Address <b>Great Bend, Kansas</b> <u>67530</u> Signed <u>Sandy Kilgus</u> Date <u>7-19-78</u> Authorized representative		

T 19 S R 10 E Sec 35 SW 1/4 SW 1/4