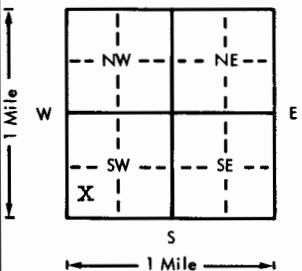


USE TYPEWRITER OR BALL POINT PEN-PRESS FIRMLY, PRINT CLEARLY.

WATER WELL RECORD
KSA 82a-1201-1215

Kansas Department of Health and Environment-Division of Environment (Water well Contractors) Topeka, Kansas 66620

1. Location of well:		County Rice	Fraction C 1/4 SW 1/4 SW 1/4	Section number 36	Township number T 19 S	Range number R 10 E
2. Distance and direction from nearest town or city: 2 West-1/4 N of Chase, Ks. Street address of well location if in city:			3. Owner of well: Leonard Ricker R.R. or street: City, state, zip code: raymond, Ks.			
4. Locate with "X" in section below: N  W E S 1 Mile			Sketch map:		6. Bore hole dia. 10 in. Completion date 11/20/75 Well depth 60 ft.	
5. Type and color of material			From	To	7. <input checked="" type="checkbox"/> Cable tool <input checked="" type="checkbox"/> Rotary <input type="checkbox"/> Driven <input type="checkbox"/> Dug <input type="checkbox"/> Hollow rod <input type="checkbox"/> Jetted <input type="checkbox"/> Bored <input type="checkbox"/> Reverse rotary	
Sandy top soil			0	1	8. Use: <input type="checkbox"/> Domestic <input type="checkbox"/> Public supply <input type="checkbox"/> Industry <input type="checkbox"/> Irrigation <input type="checkbox"/> Air conditioning <input checked="" type="checkbox"/> Stock <input type="checkbox"/> Lawn <input type="checkbox"/> Oil field water <input type="checkbox"/> Other	
Clay			1	26	9. Casing: Material pvc Height: Above or below Threaded <input type="checkbox"/> Welded <input checked="" type="checkbox"/> Surface 12 in. RMP <input type="checkbox"/> PVC <input type="checkbox"/> Weight 12 lbs./ft. Dia. 5 1/2 in. to 40 ft. depth Wall Thickness: inches or Dia. <input type="checkbox"/> in. to <input type="checkbox"/> ft. depth gage No. 1258	
Sandy clay			26	40	10. Screen: Manufacturer's name R & B Type pvc Dia. 5 1/2 Slot/gauze 1/16 Length 20 Set between 40 ft. and 60 ft. ft. and <input type="checkbox"/> ft.	
Fine sand			40	57	Gravel pack? <input checked="" type="checkbox"/> yes Size range of material 3/4 = 3/8 = 1/2	
Clay			57	60	11. Static water level: <input type="checkbox"/> mo./day/yr. 13 ft. below land surface Date 11/20/75	
					12. Pumping level below land surfaces: 18 ft. after 1 hrs. pumping 60 g.p.m. <input type="checkbox"/> ft. after <input type="checkbox"/> hrs. pumping <input type="checkbox"/> g.p.m. Estimated maximum yield 120 g.p.m.	
					13. Water sample submitted: <input type="checkbox"/> Yes <input checked="" type="checkbox"/> No Date <input type="checkbox"/>	
					14. Well head completion: <input type="checkbox"/> Pitless adapter <input type="checkbox"/> 12 Inches above grade	
					15. Well grouted? <input checked="" type="checkbox"/> yes With: <input checked="" type="checkbox"/> Neat cement <input type="checkbox"/> Bentonite <input type="checkbox"/> Concrete Depth: From 0 ft. to 10 ft.	
					16. Nearest source of possible contamination: ft. 60 Direction NE Type old well Well disinfected upon completion? <input type="checkbox"/> Yes <input type="checkbox"/> No	
					17. Pump: <input checked="" type="checkbox"/> Not installed Manufacturer's name <input type="checkbox"/> Model number <input type="checkbox"/> HP <input type="checkbox"/> Volts <input type="checkbox"/> Length of drop pipe <input type="checkbox"/> ft. capacity <input type="checkbox"/> g.p.m. Type: <input type="checkbox"/> Submersible <input type="checkbox"/> Turbine <input type="checkbox"/> Jet <input type="checkbox"/> Reciprocating <input type="checkbox"/> Centrifugal <input type="checkbox"/> Other	
					(Use a second sheet if needed)	
18. Elevation:		19. Remarks:				
Topography: <input type="checkbox"/> Hill <input type="checkbox"/> Slope <input checked="" type="checkbox"/> Upland <input type="checkbox"/> Valley						
		20. Water well contractor's certification: This well was drilled under my jurisdiction and this report is true to the best of my knowledge and belief. Rosencrantz-Bemis 134 Business name License No. Address Great Bend, Ks. Signed Judith Radson Date 11/24/75 Authorized representative				

19110E 36 Sec 1/4 1/4 1/4