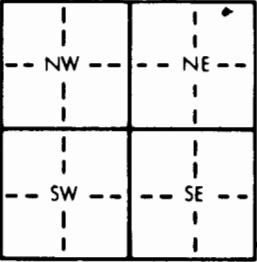


AHHRENS A-1		WATER WELL RECORD		Form WWC-5	KSA 82a-1212	
1 LOCATION OF WATER WELL:		Fraction	Section Number	Township Number	Range Number	
County: BARTON		NW 1/4 NE 1/4 NE 1/4	8	T 19 S	R 11 EW	
Distance and direction from nearest town or city street address of well if located within city?						
ELLINWOOD 4N 3/4 E SOUTHSIDE						
2 WATER WELL OWNER: L.D. DRILLING CO. INC.						
RR#, St. Address, Box #: BOX 187 B ROUTE 1						
City, State, ZIP Code: GREAT BEND, KS 67530						
Board of Agriculture, Division of Water Resources						
Application Number: T 82-611						
3 LOCATE WELL'S LOCATION WITH AN "X" IN SECTION BOX:		4 DEPTH OF COMPLETED WELL: 80 ft. ELEVATION:				
		Depth(s) Groundwater Encountered 1. DRY HOLE ft. 2. ft. 3. ft.				
		WELL'S STATIC WATER LEVEL: 11.24 ft. below land surface measured on mo/day/yr 8.2				
		Pump test data: Well water was ft. after hours pumping gpm				
		Est. Yield gpm: Well water was ft. after hours pumping gpm				
		Bore Hole Diameter: 5 7/8 in. to 80 ft. and in. to ft.				
		WELL WATER TO BE USED AS:				
		1 Domestic 3 Feedlot 6 Oil field water supply 8 Air conditioning 11 Injection well				
		2 Irrigation 4 Industrial 7 Lawn and garden only 9 Dewatering 12 Other (Specify below)				
		Was a chemical/bacteriological sample submitted to Department? Yes No If yes, mo/day/yr sample was submitted				
5 TYPE OF BLANK CASING USED: NONE		Water Well Disinfected? Yes No				
1 Steel 3 RMP (SR)		5 Wrought iron 8 Concrete tile CASING JOINTS: Glued Clamped				
2 PVC 4 ABS		6 Asbestos-Cement 9 Other (specify below) Welded				
		7 Fiberglass Threaded				
Blank casing diameter in. to ft. Dia. in. to ft.						
Casing height above land surface in. weight lbs./ft. Wall thickness or gauge No.						
TYPE OF SCREEN OR PERFORATION MATERIAL: NONE		7 PVC 10 Asbestos-cement				
1 Steel 3 Stainless steel 5 Fiberglass		8 RMP (SR) 11 Other (specify)				
2 Brass 4 Galvanized steel 6 Concrete tile		9 ABS 12 None used (open hole)				
SCREEN OR PERFORATION OPENINGS ARE: NONE		5 Gauzed wrapped 8 Saw cut 11 None (open hole)				
1 Continuous slot 3 Mill slot		6 Wire wrapped 9 Drilled holes				
2 Louvered shutter 4 Key punched		7 Torch cut 10 Other (specify)				
SCREEN-PERFORATED INTERVALS: From ft. to ft. From ft. to ft. From ft. to ft.						
GRAVEL PACK INTERVALS: From ft. to ft. From ft. to ft. From ft. to ft.						
6 GROUT MATERIAL: 1 Neat cement 2 Cement grout 3 Bentonite 4 Other						
Grout Intervals: From ft. to ft. From ft. to ft. From ft. to ft.						
What is the nearest source of possible contamination: NONE		10 Livestock pens 14 Abandoned water well				
1 Septic tank 4 Lateral lines 7 Pit privy		11 Fuel storage 15 Oil well/Gas well				
2 Sewer lines 5 Cess pool 8 Sewage lagoon		12 Fertilizer storage 16 Other (specify below)				
3 Watertight sewer lines 6 Seepage pit 9 Feedyard		13 Insecticide storage				
Direction from well?		How many feet?				
FROM	TO	LITHOLOGIC LOG	FROM	TO	LITHOLOGIC LOG	
0	8	SOIL				
8	35	CLAY				
35	45	SANDY CLAY				
45	80	CLAY				
80		BLUE SHALE				
7 CONTRACTOR'S OR LANDOWNER'S CERTIFICATION: This water well was (1) constructed, (2) reconstructed, or (3) plugged under my jurisdiction and was completed on (mo/day/year) 11.24.82 and this record is true to the best of my knowledge and belief. Kansas						
Water Well Contractor's License No. 389 This Water Well Record was completed on (mo/day/yr) 12-7-82						
under the business name of REISER WATER WELL SERV. INC. by (signature) Reiser						
INSTRUCTIONS: Use typewriter or ball point pen, PLEASE PRESS FIRMLY and PRINT clearly. Please fill in blanks, underline or circle the correct answers. Send top three copies to Kansas Department of Health and Environment, Division of Environment, Environmental Geology Section, Topeka, KS 66620. Send one to WATER WELL OWNER and retain one for your records.						

AHRENS A-1

1 LOCATION OF WATER WELL:

County: **BARTON**

Distance and direction from nearest town


ELLINWOOD 4M

2 WATER WELL OWNER: **L.D. D.**

RR#, St. Address, Box # : **BOX 1**

City, State, ZIP Code : **GREY**

3 LOCATE WELL'S LOCATION WITH AN "X" IN SECTION BOX:

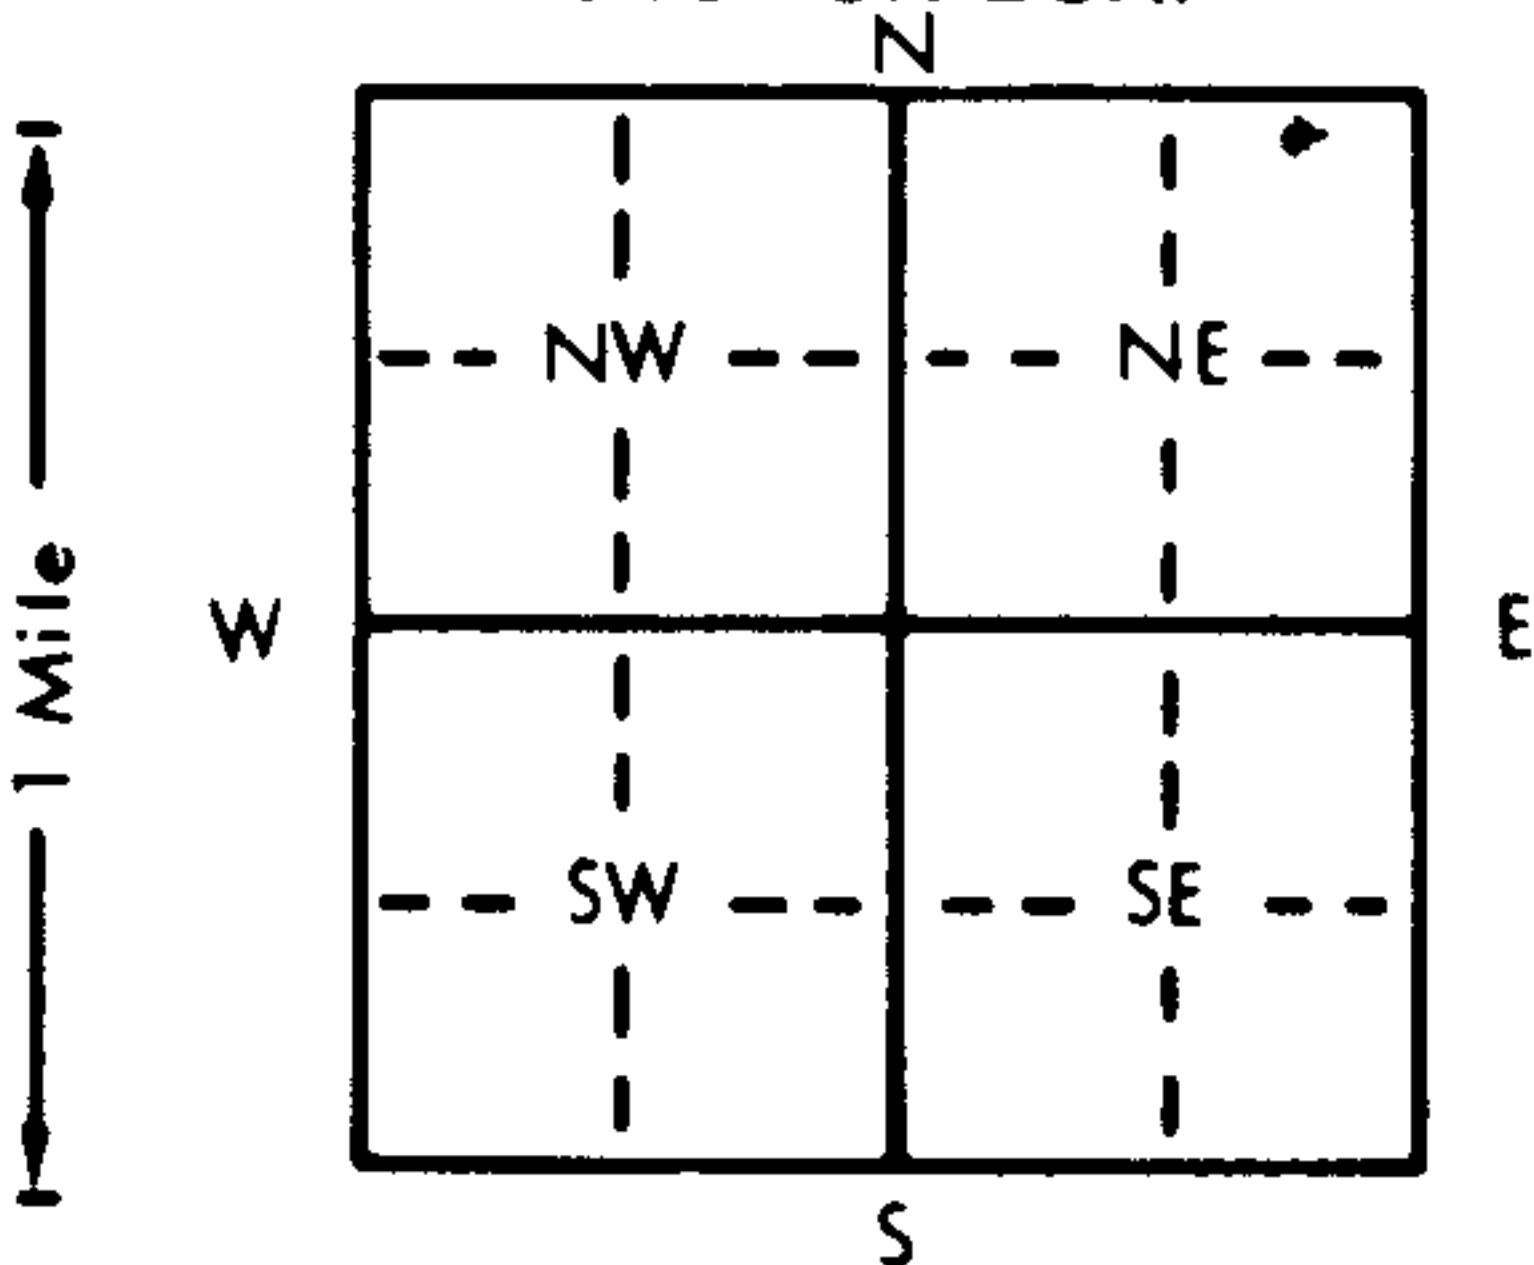

5 TYPE OF BLANK CASING USED:

1 Steel

3 RMP (SF)

2 PVC

4 ABS

Blank casing diameter