

1 LOCATION OF WATER WELL:		Fraction	Section	Township Number	Range Number
County: Barton		NE 1/4 SW 1/4 NW 1/4	25	T 19 S	R 11W E/W


Distance and direction from nearest town or city street address of well if located within city?

1½ n, 4 E of Ellinwood, Kansas

2	WATER WELL OWNER: Fred Burmeister	Red Tiger Drilling	Burmeister #1
	RR#, St. Address, Box # : Claflin, Ks.	1720 Ks. State Bank Bldg.	Board of Agriculture, Division of Water Resources
	City, State, ZIP Code : 67525	Wichita, Kansas 67202	Application Number: Unknown

3 LOCATE WELL'S LOCATION WITH AN "X" IN SECTION BOX:

4 DEPTH OF COMPLETED WELL: 50 ft. ELEVATION: Unknown

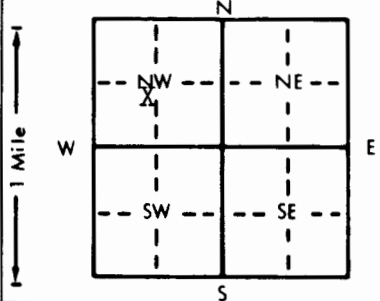

4 DEPTH OF COMPLETED WELL: 50 ft. ELEVATION: Unknown

WELL'S STATIC WATER LEVEL 6 ft. below land surface measured on mo/day/yr 10/3/85

Pump test data: Well water was _____ ft. after _____ hours pumping _____ gpm
 Est. Yield 60 gpm: Well water was _____ ft. after _____ hours pumping _____ gpm

Bore Hole Diameter. 8 in. to 50 ft. and in. to ft.

WELL WATER TO BE USED AS:			5 Public water supply	8 Air conditioning	11 Injection well
1 Domestic	3 Feedlot	<u>6. Oil field water supply</u>	9 Dewatering	12 Other (Specify below)	

2 Irrigation 4 Industrial 7 Lawn and garden only 10 Observation well

Was a chemical/bacteriological sample submitted to Department? Yes No If yes, mo/day/yr sample was sub-

Water Well Disinfected? Yes No

5) TYPE OF BLANK CASING USED:			5 Wrought iron	8 Concrete tile	CASING JOINTS: <u>Glued</u> Clamped
1 Steel	3 RMP (SR)		6 Asbestos-Cement	9 Other (specify below)	Welded

Blank casing diameter	2 PVC	4 ABS	7 Fiberglass	Threaded
	5 in to 30	ft Dia	in to ft Dia	in to ft

Casing height above land surface.....12 in., weight 2.8 lbs./ft. Wall thickness or gauge No. Sch. 40

TYPE OF SCREEN OR PERFORATION MATERIAL:

1 Steel	3 Stainless steel	5 Fiberglass	7 <u>PVC</u>	10 Asbestos-cement
			8 RMP (SR)	11 Other (specify)

2 Brass	4 Galvanized steel	6 Concrete tile	9 ABS	12 None used (open hole)
SCREEN OR PERFORATION OPENINGS ARE:		5 Gauzed wrapped	8 Saw cut	11 None (open hole)

1 Continuous slot	3 Mill slot	5 Gauzed wrapped	7 <u>Saw cut</u>	9 None (open hole)
2 Continuous slot	4 Wire wrapped	6 Wire wrapped	8 Drilled holes	

2 Louvered shutter 4 Key punched 7 Torch cut 10 Other (specify)

SCREEN-PERFORATED INTERVALS: From 30 ft. to 50 ft., From ft. to ft.

	From	ft. to	ft., From	ft. to	ft.
GRAVEL PACK INTERVALS:	From	ft. to	ft., From	ft. to	ft.

		From	ft. to	ft., From	ft. to	ft.

6] GROUT MATERIAL: 1 Neat cement 2 Cement grout 3 Bentonite 4 Other _____
Grout Intervals: From 0 ft. to 10 ft., From _____ ft. to _____ ft., From _____ ft. to _____ ft.

What is the nearest source of possible contamination:

1. Sptic tank	4. Lateral lines	7. Pit privy	10. Livestock pens	14. Abandoned water well
2. Septic tank	5. Sewer	8. Pit privy	11. Fuel storage	15. Oil well/Gas well

1 Septic tank	4 Lateral lines	7 Pit privy	11 Fuel storage	15 Sanitary landfill
2 Sewer lines	5 Cess pool	8 Sewage lagoon	12 Fertilizer storage	16 Other (specify below)

3 Watertight sewer lines 6 Seepage pit 9 Feedyard 13 Insecticide storage

Direction from well? South How many feet? 60

FROM	TO	LITHOLOGIC LOG	FROM	TO	LITHOLOGIC LOG
0	5	Clay			

5	50	Sand and Gravel			
---	----	-----------------	--	--	--

--	--	--	--	--	--

[illegible]

[illegible]

7 CONTRACTOR'S OR LANDOWNER'S CERTIFICATION: This water well was (1) constructed, (2) reconstructed, or (3) plugged under my jurisdiction and was completed on (mo/day/year) . 10/3/85. and this record is true to the best of my knowledge and belief. Kansas

Water Well Contractor's License No. 186 This Water Well Record was completed on (mo/day/yr) 11/30/85
under the business name of Kelly's Water Well Service by (signature) [Signature]

INSTRUCTIONS: Use typewriter or ball point pen, PLEASE PRESS FIRMLY and PRINT clearly. Please fill in blanks, underline or circle the correct answers. Send top three copies to Kansas Department of Health and Environment, Division of Environment, Environmental Geology Section, Topeka, KS 66620. Send one to WATER WEI

OWNER and retain one for your records.