


1 LOCATION OF WATER WELL: County: Barton		Fraction NE 1/4 UW 1/4 SE 1/4	Section Number 31	Township Number T 19 S	Range Number R 11 EW
---	--	----------------------------------	----------------------	---------------------------	-------------------------

200 E. Santa Fe Ellinwood, KS.

RR#, St. Address, Box # : 200 E. Santa Fe
City, State, ZIP Code : Ellinwood, KS. 67526

Application Number:

.....

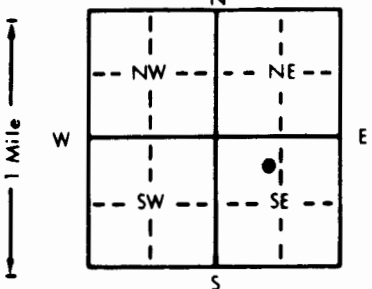

WELL'S STATIC WATER LEVEL 12.80 ft. below land surface measured on mo/day/yr 2-15-94

Est. Yield gpm: Well water was ft. after hours pumping gpm

WELL WATER TO BE USED AS:	5 Public water supply	8 Air conditioning	11 Injection well
---------------------------	-----------------------	--------------------	-------------------

2 Irrigation 4 Industrial 7 Lawn and garden only 10 Monitoring well

mitted Water Well Disinfected? Yes No

CASING JOINTS: Glued Clamped .

Welded

Threads

Casing height above land surface Flush Mounted in. weight lbs./ft. Wall thickness or gauge No. SDR. 13

10 Asbestos-cement SCH 40

11 Other (specify)

12 None used (open hole)

8 Saw cut 11 None (open hole)

9 Drilled holes

10 Other (specify)

From ft. to ft. From ft. to ft.

From	ft. to	ft., From	ft. to	ft.
------	--------	-----------	--------	-----

Grout Intervals: From 8 ft. to 4 ft., From 4 ft. to 0 ft., From _____ ft. to _____ ft.

1 Septic tank	4 Lateral lines	7 Pit privy	11 Fuel storage	15 Oil well/Gas well
---------------	-----------------	-------------	-----------------	----------------------

(11) Fuel storage

12 Fertilizer storage

13 Insecticide storage

How many feet? **350'**

[illegible]

Water Well Contractor's License No. 539 This Water Well Record was completed on (mo/day/yr) 2-21-94

under the business name of JB Environmental Drilling

by (signature) James Bioker

INSTRUCTIONS: Use typewriter or ball point pen. PLEASE PRESS FIRMLY and PRINT clearly. Please fill in blanks, underline or circle the correct answers. Send top three copies to Kansas Department of Health and Environment, Bureau of Water, Topeka, Kansas 66620-0001. Telephone: 913-296-5545. Send one to WATER WELL OWNER and retain one for your records.