


1 LOCATION OF WATER WELL: County: Barton	Fraction C1/2 1/4 NW 1/4 SW 1/4	Section Number 32	Township Number T 19 S	Range Number R 11 E(W)
---	------------------------------------	----------------------	---------------------------	---------------------------

Distance and direction from nearest town or city street address of well if located within city?
408 E. 6th St. Ellinwood, Ks. 67526

2	WATER WELL OWNER:	Paula Blehm	
	RR#, St. Address, Box # :	408 E. 6th. St.	Board of Agriculture, Division of Water Resources
	City, State, ZIP Code :	Ellinwood, Ks. 67526	Application Number:

3 LOCATE WELL'S LOCATION WITH AN "X" IN SECTION BOX: 4 DEPTH OF COMPLETED WELL: 44 ft. ELEVATION: Unknown

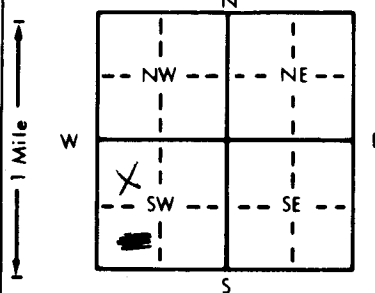

4. DEPTH OF COMPLETED WELL. 44 ft. ELEVATION: Unknown

Depth(s) Groundwater Encountered 1 17 ft. 2. ft. 3. ft.

WELL'S STATIC WATER LEVEL 17 ft. below land surface measured on mo/day/yr 3-23-89

Pump test data: Well water was _____ ft. after _____ hours pumping _____ gpm

Est. Yield 40 gpm: Well water was _____ ft. after _____ hours pumping _____ gpm

Bore Hole Diameter. 8 in. to 44 ft., and _____ in. to _____ ft.

WELL WATER TO BE USED AS:

5 Public water supply	8 Air conditioning	11 Injection well
1 Domestic	3 Feedlot	6 Oil field water supply
2 Irrigation	4 Industrial	7 <u>Lawn and garden only</u>
		10 Monitoring well

Was a chemical/bacteriological sample submitted to Department? Yes _____ No X _____; If yes, mo/day/yr sample was submitted _____

Water Well Disinfected? Yes X No _____

5	TYPE OF BLANK CASING USED:		5 Wrought iron	8 Concrete tile	CASING JOINTS: Glued Clamped Welded Threaded
	1 Steel	3 RMP (SR)	6 Asbestos-Cement	9 Other (specify below)	
	2 <u>PVC</u>	4 ABS	7 Fiberglass		

Blank casing diameter 5 in. to 34 ft. Dia. in. to ft. Dia. in. to ft.
Casing height above land surface 12 in. weight 2.8 lbs./ft. Wall thickness or gauge No. SCH. 40

TYPE OF SCREEN OR PERFORATION MATERIAL:			<u>7 PVC</u>	10 Asbestos-cement
1 Steel	3 Stainless steel	5 Fiberglass	8 RMP (SR)	11 Other (specify)
2 Brass	4 Galvanized steel	6 Concrete tile	9 ABS	12 None used (open hole)

SCREEN OR PERFORATION OPENINGS ARE:		5 Gauzed wrapped	<u>8 Saw cut</u>	11 None (open hole)
1 Continuous slot	3 Mill slot	6 Wire wrapped	9 Drilled holes	
2 Louvered shutter	4 Key punched	7 Torch cut	10 Other (specify)	

SCREEN-PERFORATED INTERVALS: From 34 ft. to 44 ft., From ft. to ft.
From ft. to ft., From ft. to ft.
GRAVEL PACK INTERVALS: From 20 ft. to 44 ft., From ft. to ft.
From ft. to ft., From ft. to ft.

6] GROUT MATERIAL: 1 Neat cement 2 Cement grout 3 Bentonite 4 Other _____
Grout Intervals: From 0 ft. to 20 ft., From _____ ft. to _____ ft.

What is the nearest source of possible contamination:

1 Septic tank	4 Lateral lines	7 Pit privy	10 Livestock pens	14 Abandoned water well
2 Sewer lines	5 Cess pool	8 Sewage lagoon	11 Fuel storage	15 Oil well/Gas well
<u>3 Watertight sewer lines</u>	6 Seepage pit	9 Feedyard	12 Fertilizer storage	16 Other (specify below)
			13 Insecticide storage	

Direction from well? East How many feet? 50

[illegible]

7 CONTRACTOR'S OR LANDOWNER'S CERTIFICATION: This water well was (1) constructed, (2) reconstructed, or (3) plugged under my jurisdiction and was completed on (mo/day/year) 3-23-89 and this record is true to the best of my knowledge and belief. Kansas Water Well Contractor's License No. 186 This Water Well Record was completed on (mo/day/yr) 5-18-89 under the business name of Kelley's Water Well Service by (signature) Deon Davis