

1 LOCATION OF WATER WELL:		Fraction		Section Number	Township Number		Range Number	
County: Barton		NW ¼	NW ¼	32	T 19	S	R 11	E/W


Distance and direction from nearest town or city street address of well if located within city?
601 E. Santa Fe, Ellinwood

2 WATER WELL OWNER: **Ellinwood Tank Service**

RR#, St. Address, Box # : 601 E. Santa Fe
City, State, ZIP Code : Ellinwood, Kansas 67526

Board of Agriculture, Division of Water Resources
Application Number: _____

3] LOCATE WELL'S LOCATION
WITH AN "X" IN SECTION BOX:

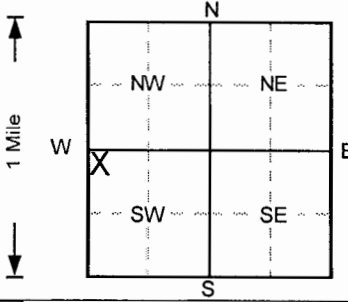

4 DEPTH OF COMPLETED WELL 20 ft. ELEVATION:

Depth(s) Groundwater Encountered 1. 14 ft. 2. ft. 3. ft.

WELL'S STATIC WATER LEVEL ft. below land surface measured on mo/day/yr

Est. Yield . . . **NA** . . . gpm: Well water was ft. after hours pumping gpm

Bore Hole Diameter . . . 8 . . . in. to . . . 20 . . . ft., and in. to ft.

WELL WATER TO BE USED AS:

5 Public water supply	8 Air conditioning	11 Injection well
6 Oil field water supply	9 Dewatering	12 Other (Specify below)

1 Domestic 3 Feedlot 6 Oil field water supply 9 Dewatering 12 Other (Specify below)
2 Irrigation 4 Industrial 7 Lawn and garden only 10 Monitoring well

Was a chemical/bacteriological sample submitted to Department? Yes.....No ☒ ; If yes, mo/day/yr sample was

Water Well Disinfected? Yes _____ No ☒

5] TYPE OF BLANK CASING USED:

5 Wrought iron 8 Concrete tile CASING JOINTS: Glued Clamped

CASING JOINTS: Glued Clamped

1 Steel 3 RMP (SR) 6 Asbestos-Cement 9 Other (specify below) Welded

2 PVC 4 ABS 7 Fiberglass Threaded ☒

Blank casing diameter **2** in. to **10** ft. Dia in. to ft. Dia in. to ft.

Casing height above land surface **24** in., weight lbs./ft. Wall thickness or gauge No. **Sch. 40**

TYPE OF SCREEN OR PERFORATION MATERIAL

1 Steel	3 Stainless steel	5 Fiberglass	8 RMP (SR)	11 Other (specify)
2 Brass	4 Galvanized steel	6 Concrete tile	9 ABS	12 None used (open hole)

SCREEN OR PERFORATION OPENINGS ARE:

1 Continuous slot **3** Mill slot 6 Wire wrapped 9 Drilled holes

2 Louvered shutter 4 Key punched 7 Torch cut 10 Other (specify)


SCREEN-PERFORATED INTERVALS: From 10 ft. to 20 ft., From ft. to ft.
From ft. to ft. From ft. to ft.

GRAVEL PACK INTERVALS: From8..... ft. to20..... ft., From ft. to ft.

From ft. to ft., From ft. to ft.

6 GROUT MATERIAL: 1 Neat cement 2 Cement grout 3 Bentonite 4 Other


What is the nearest source of possible contamination: 10 Livestock pens 14 Abandoned water well

1 Septic tank	4 Lateral lines	7 Pit privy	11 Fuel storage	15 Oil well/Gas well
---------------	-----------------	-------------	-----------------	----------------------

2 Sewer lines 5 Cess pool 8 Sewage lagoon 12 Fertilizer storage 16 Other (specify below)

3 Watertight sewer lines 6 Seepage pit 9 Feedyard 13 Insecticide storage

Direction from well? How many feet?

FROM			TO		
LITHOLOGIC LOG			PLUGGING INTERVALS		

0	3	Clay, sandy, organics, Dark Brown			
3	6	Clay, plastic, stiff, no odor, Brown			
6	11	Clay, silty, tr. vf sand, stiff, moist, Brown			
11	13	Sand (vf-f), Brown			
13	15	Sand (vf-m), strong odor, Gray			
15	20	Sand (f-c), sm. gravel, saturated,			
					MW27 , Tag # 00366540 , Abovegrade
					Project Name: GF - Ellinwood Tank Service
					GeoCore # 1026 , KDHE # U6 005 11603

7 CONTRACTOR'S OR LANDOWNER'S CERTIFICATION: This water well was (1) constructed, (2) reconstructed, or (3) plugged under my jurisdiction and was completed on (mo/day/year) 12/2/2005 and this record is true to the best of my knowledge and belief.
Kansas Water Well Contractor's License No. 527 This Water Well Record was completed on (mo/day/yr) 12/8/05
under the business name of GeoCore, Inc. by (signature) Dale Rapp