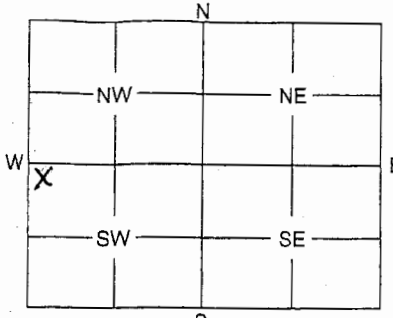


1 LOCATION OF WATER WELL:	Fraction	Section Number	Township Number	Range Number
County: <u>Barton</u>	<u>NW 1/4 NW 1/4 SW 1/4</u>	<u>32</u>	<u>19 S</u>	<u>11</u> EW

Distance and direction from nearest town or city street address of well if located within city?
604 East Santa Fe Ellinwood KS 67526

2 WATER WELL OWNER: <u>Bob's Oil Service</u>	Board of Agriculture, Division of Water Resources
RR #, St. Address, Box #: <u>604 E. Santa Fe</u>	Application Number:
City, State, ZIP Code: <u>Ellinwood KS 67526</u>	

3 MARK WELL'S LOCATION WITH AN "X" IN SECTION BOX: 	4 DEPTH OF WELL <u>20</u> ft. WELL'S STATIC WATER LEVEL <u>13</u> ft. WELL WAS USED AS: <table style="width: 100%;"> <tr> <td>1 Domestic</td> <td>5 Public Water Supply</td> <td>9 Dewatering</td> </tr> <tr> <td>2 Irrigation</td> <td>6 Oil Field Water Supply</td> <td><u>10</u> Monitoring Well</td> </tr> <tr> <td>3 Feedlot</td> <td>7 Domestic (Lawn & Garden)</td> <td>11 Injection Well</td> </tr> <tr> <td>4 Industrial</td> <td>8 Air Conditioning</td> <td>12 Other</td> </tr> </table> Was a chemical / bacteriological sample submitted to Department? Yes No <u>X</u>..... If yes, mo/day/yr sample was submitted Water Well Disinfected: Yes No <u>X</u>.....	1 Domestic	5 Public Water Supply	9 Dewatering	2 Irrigation	6 Oil Field Water Supply	<u>10</u> Monitoring Well	3 Feedlot	7 Domestic (Lawn & Garden)	11 Injection Well	4 Industrial	8 Air Conditioning	12 Other

5 TYPE OF BLANK CASING USED:			
1 Steel	3 RMP (SR)	5 Wrought	7 Fiberglass
<u>2 PVC</u>	4 ABS	6 Asbestos-Cement	8 Concrete Tile
9 Other (Specify below)			
Blank casing diameter <u>2</u> in.		Was casing pulled? Yes <u>X</u> No	
Casing height above or below land surface		If yes, how much <u>3'</u>	

6 GROUT PLUG MATERIAL:			
1 Neat cement	2 Cement grout	<u>3 Bentonite</u>	4 Other
Grout Plug Intervals: From <u>20</u> ft. to <u>3</u> ft., From ft. to ft., From ft. to ft.			
What is the nearest source of possible contamination:			
1 Septic tank	6 Seepage pit	11 Fuel storage	16 Other (specify below)
<u>2</u> Sewer lines	7 Pit privy	12 Fertilizer storage	
3 Watertight sewer lines	8 Sewage lagoon	13 Insecticide storage	
4 Lateral lines	9 Feedyard	14 Abandoned water well	
5 Cess pool	10 Livestock pens	15 Oil well/Gas well	
Direction from well? <u>W</u>		How many feet? <u>50</u>	

FROM	TO	PLUGGING MATERIALS
20'	3'	<u>Bentonite Chips</u>
3'	0'	<u>Native Material / Concrete</u>

7	CONTRACTOR'S OF LANDOWNER'S CERTIFICATION: This water well was plugged under my jurisdiction and was completed on (mo/day/year) <u>10-19-07</u> and this record is true to the best of my knowledge and belief. Kansas Water Well Contractor's License No. <u>11-27-07</u> under the business name of <u>GreenField Contractors</u> by (signature) <u>Joan Peckham</u>
---	---

INSTRUCTIONS: Use typewriter or ball point pen. Please press firmly and print clearly. Please fill in blanks, underline or circle the correct answers. Send top three copies to Kansas Department of Health and Environment, Bureau of Water, Geology Section, 1000 SW Jackson St., Ste. 420, Topeka, Kansas 66612-1367. Telephone: 785/296-5522. Send one to Water Well Owner and retain one for your records.