WATER WELL PLUGGING RECORD Form WWC-5P KSA 82a-1212 ID NO. MW-27

1 LOCATION OF WATER WELL: County: Barton | Fraction: SE ¼ NW¼ NW ¼ SE ¼ | Section Number: 31 | Township Number: T 19 S | Range Number: 11 ☐ E ☑ W

Street/Rural Address of Well Location; if unknown, distance & direction from nearest town or intersection: If at owner's address, check here ☐ American Legion
117 E Santa Fe Blvd
Ellinwood, KS 67526

Global Positioning Systems (GPS) information:
Latitude: 38.353396 (in decimal degrees)
Longitude: -98.579899 (in decimal degrees)
Elevation: 1787.76
Horizontal Datum: ☑ WGS84, ☐ NAD83, ☐ NAD27
Collection Method:
☐ GPS unit (Make/Model: _____)
☑ Digital Map/Photo, ☐ Topographic Map, ☐ Land Survey
Est. Accuracy: ☑ < 3 m, ☐ 3-5 m, ☐ 5-15 m, ☐ > 15 m

2 WATER WELL OWNER: Debbie Albert - Legacy Bank
RR#, St. Address, Box #: 3711 N. Ridge Rd.
City, State ZIP Code: Wichita, KS 67205

3 MARK WELL'S LOCATION WITH AN "X" IN SECTION BOX:

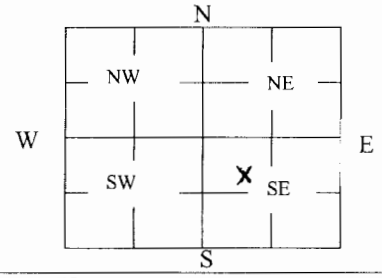

4 DEPTH OF WELL 18 ft.
WELL'S STATIC WATER LEVEL Unknown ft
WELL WAS USED AS:

☐ Domestic	☐ Public Water Supply	☐ Dewatering
☐ Irrigation	☐ Oil Field Water Supply	☑ Monitoring
☐ Feedlot	☐ Domestic (Lawn & Garden)	☐ Injection Well
☐ Industrial	☐ Air Conditioning	☐ Other _____

Was a chemical/bacteriological sample submitted to Department? Yes ☐ No ☑

5 TYPE OF BLANK CASING USED:

☐ Steel	☐ RMP (SR)	☐ Wrought	☐ Fiberglass	☐ Other (Specify below)
☑ PVC	☐ ABS	☐ Asbestos-Cement	☐ Concrete Tile	

Blank casing diameter 2 in. Was casing pulled? Yes ☑ No ☐ If yes, how much 3 feet
Casing height above or below land surface -36 in.

6 GROUT PLUG MATERIAL: ☐ Neat cement ☐ Cement grout ☑ Bentonite ☐ Other _____

Grout Plug Intervals: From 12 ft. to 3 ft., From _____ ft. to _____ ft., From _____ ft. to _____ ft.

What is the nearest source of possible contamination:

☐ Septic tank	☐ Seepage pit	☑ Fuel storage	☐ Other (specify below)
☐ Sewer lines	☐ Pit privy	☐ Fertilizer storage	
☐ Watertight sewer lines	☐ Sewage lagoon	☐ Insecticide storage	
☐ Lateral lines	☐ Feedyard	☐ Abandoned water well	Direction from well? NW
☐ Cess pool	☐ Livestock pens	☐ Oil well/Gas well	How many feet? 140

FROM	TO	PLUGGING MATERIALS	FROM	TO	PLUGGING MATERIALS
0	3	Soil			MW-27
3	12	Bentonite Chips			Stop 2 Shop - U6-005-10039
					Well was damaged and bridged at 12'
					bgs with soil above groundwater.
					Attempted to break through the bridged
					soil to no avail.

7 CONTRACTOR'S OR LANDOWNER'S CERTIFICATION: This water well was plugged under my jurisdiction and was completed on (mo/day/year) 1/30/2017 and this record is true to the best of my knowledge and belief. Kansas Water Well Contractor's License No. KDHE. This Water Well Record was completed on (mo/day/year) 2/2/2018 under the business name of KDHE by (signature) _____

Send one white copy to Kansas Department of Health & Environment, Geology Section, 1000 SW Jackson Street, Ste. 420, Topeka, KS 66612-1367. Send one copy to WATER WELL OWNER and retain one for your records.
Visit us at http://www.kdheks.gov/waterwell/index.html Telephone 785-296-5524.