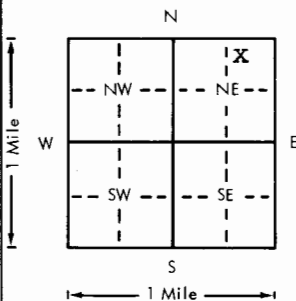


USE TYPEWRITER OR BALL
POINT PEN-PRESS FIRMLY,
PRINT CLEARLY.

WATER WELL RECORD
KSA 82a-1201-1215

Kansas Department of Health and
Environment-Division of Environment
(Water well Contractors)
Topeka, Kansas 66620

1. Location of well:	County Barton	Fraction nw 1/4 ne 1/4 ne 1/4	Section number 15	Township number T 19 S R 12 E	Range number 12
2. Distance and direction from nearest town or city: 3-N 1 1/2-E of Dartmouth, Ks. Street address of well location if in city:			3. Owner of well: Carl Madden R.R. or street: Rt. 3 City, state, zip code: Great Bend, Kansas 67530		
4. Locate with "X" in section below: 			Sketch map:		
5. Type and color of material			From	To	6. Bore hole dia. 8 in. Completion date 7-21-75 Well depth 63 ft.
top soil			0	2	7. ☒ Cable tool ☒ Rotary ☐ Driven ☐ Dug ☐ Hollow rod ☐ Jetted ☐ Bored ☐ Reverse rotary
Brown & white clay			2	11	8. Use: ☒ Domestic ☐ Public supply ☐ Industry ☐ Irrigation ☐ Air conditioning ☐ Stock ☐ Lawn ☐ Oil field water ☐ Other
sandy brown clay			11	20	9. Casing: Material pvc Height: Above ground 18 in. Threaded ☐ Welded ☐ Surface 18 in. RMP ☐ PVC ☒ Weight 18 lbs./ft. Dia. 4 in. to 63 ft. depth Wall Thickness: inches or Dia. 4 in. to 63 ft. depth gage No. .237
brown & white clay			20	42	10. Screen: Manufacturer's name CertainTeed Type pvc Dia. 4 in. Slot size 1/16 Length 23 ft. Set between 40 ft. and 63 ft. Gravel pack? ☒ Size range of material 3/4 3/8
sandy brown clay			42	58	11. Static water level: 42 ft. below land surface Date 7-21-75 mo./day/yr.
broken sand rock			58	62	12. Pumping level below land surfaces: na ft. after 0 hrs. pumping 0 g.p.m. ft. after 0 hrs. pumping 0 g.p.m. Estimated maximum yield 0 g.p.m.
yellow brown sandy clay			62	64	13. Water sample submitted: na ☒ Yes ☐ No Date 7-21-75 mo./day/yr.
fire clay			64	67	14. Well head completion: ☐ Pitless adapter ☐ Inches above grade
					15. Well grouted? ☒ With ☒ Neat cement ☐ Bentonite ☐ Concrete Depth: From 0 ft. to 10 ft.
					16. Nearest source of possible contamination: ft. 250 Direction ne Type septic Well disinfected upon completion? ☒ Yes ☐ No
					17. Pump: ☒ Not installed Manufacturer's name _____ Model number _____ HP _____ Volts _____ Length of drop pipe _____ ft. capacity _____ g.p.m. Type: ☐ Submersible ☐ Turbine ☐ Jet ☐ Reciprocating ☐ Centrifugal ☐ Other
(Use a second sheet if needed)					
18. Elevation: Topography: ☐ Hill ☐ Slope ☒ Upland ☐ Valley	19. Remarks: 15		20. Water well contractor's certification: This well was drilled under my jurisdiction and this report is true to the best of my knowledge and belief. Rosencrantz-Bemis 134 Business name License No. Address Great Bend, Kansas 67530 Signed Sandy K. Moore Date 7-19-79 Authorized representative		

Forward the white, blue and pink copies to the Department of Health and Environment

Form WWC-5