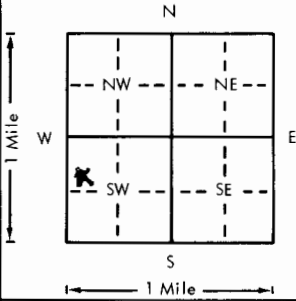


USE TYPEWRITER OR BALL
POINT PEN-PRESS FIRMLY,
PRINT CLEARLY.

WATER WELL RECORD
KSA 82a-1201-1215

Kansas Department of Health and
Environment-Division of Environment
(Water well Contractors)
Topeka, Kansas 66620

1. Location of well:		County Barton	Fraction SW 1/4 NW 1/4	Section number 30	Township number T 19 S	Range number R 12 W
2. Distance and direction from nearest town or city: 3 E		3. Owner of well: WOODMAN TANNING DRUG INC				
Street address of well location if in city: Great Bend, KS		R.R. or street: BOX 308				
		City, state, zip code: Great Bend, KS				
4. Locate with "X" in section below:		Sketch map:				
						
5. Type and color of material		From	To	6. Bore hole dia. 6 in. Completion date 7-18-77		
				Well depth 40 ft.		
				7. ☐ Cable tool ☒ Rotary ☐ Driven ☐ Dug		
				☐ Hollow rod ☐ Jetted ☐ Bored ☐ Reverse rotary		
				8. Use: ☐ Domestic ☐ Public supply ☐ Industry		
				☐ Irrigation ☐ Air conditioning ☐ Stock		
				☐ Lawn ☒ Oil field water ☐ Other		
				9. Casing: Material ☐ Threaded ☐ Welded ☐ RMP ☐ PVC ☒		
				Height: Above ☐ below ☒ Surface 13 in.		
				Weight 15 lbs./ft.		
				Dia. 2 in. to 40 ft. depth		
				Wall Thickness: inches or		
				Dia. 2 in. to 40 ft. depth		
				gauge No. Sch 40		
				10. Screen: Manufacturer's name MPI		
				Type PVC Dia. 2"		
				Slot/gauze 1/16" Length 15'		
				Set between 25 ft. and 40 ft.		
				Gravel pack? ☒ Size range of material 1/8-3/4		
				11. Static water level: 10 ft. below land surface Date 7-18-77		
				12. Pumping level below land surfaces:		
				50 g.p.m.		
				Estimated maximum yield 50 g.p.m.		
				13. Water sample submitted: ☒ Yes ☐ No Date		
				14. Well head completion: ☐ Pitless adapter ☒ 12 inches above grade		
				15. Well grouted? ☒ With: ☒ Neat cement ☐ Bentonite ☐ Concrete		
				Depth: From 0 ft. to 10 ft.		
				16. Nearest source of possible contamination: 60 ft. Direction SE Type Test		
				Well disinfected upon completion? ☐ Yes ☒ No		
				17. Pump: ☒ Not installed		
				Manufacturer's name		
				Model number HP Volts		
				Length of drop pipe ft. capacity g.p.m.		
				Type: ☐ Submersible ☐ Turbine		
				☐ Jet ☐ Reciprocating		
				☐ Centrifugal ☐ Other		
18. Elevation:		19. Remarks:				
Topography: ☐ Hill ☐ Slope ☒ Upland ☒ Valley		1725				
		20. Water well contractor's certification: This well was drilled under my jurisdiction and this report is true to the best of my knowledge and belief. 196 Business name Kelly's Water Well Ser License No. 196 Address R 2 Great Bend, KS Signed Kelly Price Date 8-11-77 Authorized representative				

Forward the white, blue and pink copies to the Department of Health and Environment

Form WWC-5