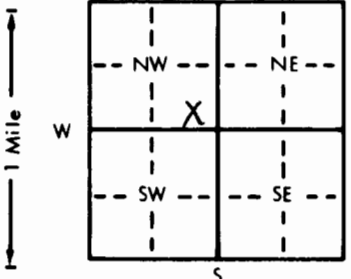


1 LOCATION OF WATER WELL:	Fraction	Section Number	Township Number	Range Number
County: <u>Barton</u>	<u>SE</u> $\frac{1}{4}$ <u>SE</u> $\frac{1}{4}$ <u>NW</u> $\frac{1}{4}$	<u>36</u>	<u>T 19 S</u>	<u>R 12</u> <u>XEW</u>

Distance and direction from nearest town or city street address of well if located within city?

One mile west of Ellinwood

2 WATER WELL OWNER: <u>Flora Birzer</u>	Board of Agriculture, Division of Water Resources
RR#, St. Address, Box # :	Application Number: <u>T82-500</u>
City, State, ZIP Code <u>Ellinwood, Kansas 67526</u>	

3 LOCATE WELL'S LOCATION WITH AN "X" IN SECTION BOX:	4 DEPTH OF COMPLETED WELL: <u>45</u> ft. ELEVATION: <u>1794</u>
	Depth(s) Groundwater Encountered 1. ft. 2. ft. 3. ft. WELL'S STATIC WATER LEVEL <u>17</u> ft. below land surface measured on mo/day/yr Pump test data: Well water was ft. after hours pumping gpm Est. Yield gpm: Well water was ft. after hours pumping gpm Bore Hole Diameter. <u>10 3/4</u> in. to <u>45</u> ft., and in. to ft. WELL WATER TO BE USED AS: 5 Public water supply 8 Air conditioning 11 Injection well 1 Domestic 3 Feedlot <u>6 Oil field water supply</u> 9 Dewatering 12 Other (Specify below) 2 Irrigation 4 Industrial 7 Lawn and garden only 10 Observation well Was a chemical/bacteriological sample submitted to Department? Yes.....No..... <u>X</u>; If yes, mo/day/yr sample was submitted Water Well Disinfected? Yes <u>HTH</u> No

5 TYPE OF BLANK CASING USED:	5 Wrought iron	8 Concrete tile	CASING JOINTS: Glued <u>X</u> Clamped
1 Steel	3 RMP (SR)	6 Asbestos-Cement	9 Other (specify below)
<u>2 PVC</u>	4 ABS	7 Fiberglass	Welded
Blank casing diameter in. to ft., Dia. in. to ft., Dia. in. to ft.			Threaded
Casing weight above land surface. <u>3'</u> in., weight lbs./ft. Wall thickness or gauge No. <u>258</u>			
TYPE OF SCREEN OR PERFORATION MATERIAL:	7 PVC	10 Asbestos-cement	
1 Steel	3 Stainless steel	5 Fiberglass	8 RMP (SR)
2 Brass	4 Galvanized steel	6 Concrete tile	9 ABS
11 Other (specify)			12 None used (open hole)
SCREEN OR PERFORATION OPENINGS ARE:	5 Gauzed wrapped	8 Saw cut	11 None (open hole)
1 Continuous slot	3 Mill slot	6 Wire wrapped	9 Drilled holes
2 Louvered shutter	4 Key punched	7 Torch cut	10 Other (specify)
SCREEN-PERFORATED INTERVALS: From <u>20</u> ft. to <u>40</u> ft., From ft. to ft.			
GRAVEL PACK INTERVALS: From <u>10</u> ft. to <u>40</u> ft., From ft. to ft.			

6 GROUT MATERIAL:	1 Neat cement	<u>2 Cement grout</u>	3 Bentonite	4 Other
Grout Intervals: From <u>0</u> ft. to <u>10</u> ft., From ft. to ft.				
What is the nearest source of possible contamination:	1 Septic tank	4 Lateral lines	7 Pit privy	10 Livestock pens
	2 Sewer lines	5 Cess pool	8 Sewage lagoon	11 Fuel storage
	3 Watertight sewer lines	6 Seepage pit	9 Feedyard	12 Fertilizer storage
				13 Insecticide storage
Direction from well?				How many feet? <u>50 +</u>

FROM	TO	LITHOLOGIC LOG	FROM	TO	LITHOLOGIC LOG
0	5	Top Soil			
5	13	Tan Clay			
13	45	Sand & Gravel			
		Well plugged with			
		2 3/4 cu. ft. gravel	40	20	
		3 sx cement	20	3	
		pipe cut off 3' below			
		G.L.-filled to surface			
		w/soil & silt	3	0	

7 CONTRACTOR'S OR LANDOWNER'S CERTIFICATION: This water well was (1) constructed, (2) reconstructed, or (3) plugged under my jurisdiction and was completed on (mo/day/year) <u>10-20-82</u> and this record is true to the best of my knowledge and belief. Kansas Water Well Contractor's License No. This Water Well Record was completed on (mo/day/yr) <u>2-11-85</u> under the business name of <u>Ladd Petroleum Corporation</u> by (signature) <u>[Signature]</u>
INSTRUCTIONS: Use typewriter or ball point pen, <u>PLEASE PRESS FIRMLY</u> and <u>PRINT</u> clearly. Please fill in blanks, underline or circle the correct answers. Send top three copies to Kansas Department of Health and Environment, Division of Environment, Environmental Geology Section, Topeka, KS 66620. Send one to WATER WELL OWNER and retain one for your records.