

1 LOCATION OF WATER WELL:	Fraction	Section Number	Township Number	Range Number
County: Barton	SW ¼ SE ¼ SW ¼	29	T 19 S	R 12 EW

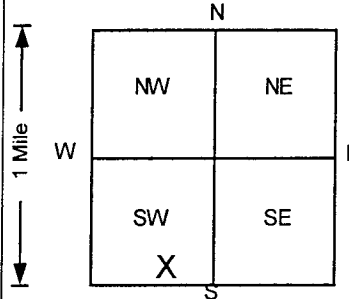
Distance and direction from nearest town or city street address of well if located within city?

3.5 miles E of Great Bend, on E. Barton Co. Rd2 WATER WELL OWNER: **Rice Engineering Corporation**RR#, St. Address, Box # : **1030 Andrews Hwy, Suite 200**City, State, ZIP Code : **Midland, Texas 79701-3872**

Board of Agriculture, Division of Water Resources

Application Number:

3 LOCATE WELL'S LOCATION WITH AN "X" IN SECTION BOX:

4 DEPTH OF COMPLETED WELL: **69.5** ft. ELEVATION: **0**Depth(s) Groundwater Encountered 1. **12.5** ft. 2. **12.5** ft. 3. **12.5** ft.WELL'S STATIC WATER LEVEL **12.5** ft. below land surface measured on mo/day/yrPump test data: Well water was **NA** ft. after **NA** hours pumping **NA** gpmEst. Yield **NA** gpm: Well water was **NA** ft. after **NA** hours pumping **NA** gpmBore Hole Diameter **7** in. to **85** ft. and **85** in. to **85** ft.

WELL WATER TO BE USED AS: 5 Public water supply 8 Air conditioning 11 Injection well

1 Domestic 3 Feedlot 6 Oil field water supply 9 Dewatering 12 Other (Specify below)


5 TYPE OF BLANK CASING USED:

1 Steel 3 RMP (SR)

2 PVC 4 ABS

5 Wrought iron

6 Asbestos-Cement

7 Fiberglass

8 Concrete tile

9 Other (specify below)


TYPE OF SCREEN OR PERFORATION MATERIAL

1 Steel 3 Stainless steel

2 Brass 4 Galvanized steel

5 Fiberglass

6 Concrete tile

7 PVC

8 RMP (SR)

9 ABS

10 Asbestos-cement

11 Other (specify)

12 None used (open hole)

SCREEN OR PERFORATION OPENINGS ARE:

1 Continuous slot **3** Mill slot

2 Louvered shutter 4 Key punched

5 Gauzed wrapped

6 Wire wrapped

7 Torch cut

8 Saw cut

9 Drilled holes

10 Other (specify) **10**

11 None (open hole)



6 GROUT MATERIAL:

1 Neat cement

2 Cement grout**3** Bentonite

4 Other

Grout Intervals: From **0** ft. to **48** ft. From **48** ft. to **56.5** ft. From **56.5** ft. to **85** ft.

What is the nearest source of possible contamination:

1 Septic tank

2 Sewer lines

3 Watertight sewer lines

4 Lateral lines

5 Cess pool

6 Seepage pit

7 Pit privy

8 Sewage lagoon

9 Feedyard

10 Livestock pens

11 Fuel storage

12 Fertilizer storage

13 Insecticide storage

14 Abandoned water well

15 Oil well/Gas well

16 Other (specify below)**Manufacturing facility**Direction from well? **west**How many feet? **800**

FROM	TO	LITHOLOGIC LOG	FROM	TO	PLUGGING INTERVALS
0	2	Clay,			
2	8	Clay, Dark Grayish Brown			
8	11	Clay, Tan			
11	31	Sand,			
31	43.5	Sand,			
43.5	44	Clay, Orangish Yellow			
44	49	Clay, Gray			
49	56	Sand and Gravel,			
56	58	Clay, Tan and Brown			
58	59	Clay, White and Pink			
59	68	Sand,			
68	85	Sandstone, Orangish Brown			
					MW13, Tag #, Abovegrade
					Project Name: Rice Engineering
					GeoCore # 368, #

7 CONTRACTOR'S OR LANDOWNER'S CERTIFICATION: This water well was **(1)** constructed, (2) reconstructed, or (3) plugged under my jurisdiction and was completed on (mo/day/year) **8/30/00** and this record is true to the best of my knowledge and belief.

Kansas Water Well Contractor's License No. **527** This Water Well Record was completed on (mo/day/yr) **9/26/00**

under the business name of **GeoCore Services, Inc.** by (signature) **Dale Pohl**