

1 LOCATION OF WATER WELL:	Fraction	Section Number	Township Number	Range Number
County: Barton	SE ¼ SW ¼ SW ¼	29	T 19 S	R 12 E EW

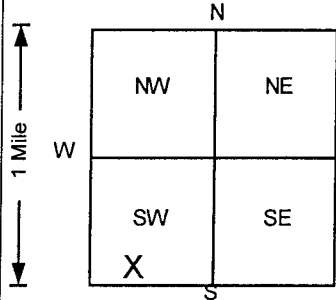
Distance and direction from nearest town or city street address of well if located within city?

3.5 miles E of Great Bend on E. Barton Co. Rd.2 WATER WELL OWNER: **Rice Engineering Corporation**RR#, St. Address, Box # : **1030 Andrews Hwy, Suite 200**City, State, ZIP Code : **Midland, Texas 79701-3872**

Board of Agriculture, Division of Water Resources

Application Number:

3 LOCATE WELL'S LOCATION WITH AN "X" IN SECTION BOX:

4 DEPTH OF COMPLETED WELL: **23** ft. ELEVATION: **0**Depth(s) Groundwater Encountered 1. **11** ft. 2. **11** ft. 3. **11** ft.WELL'S STATIC WATER LEVEL **11.23** ft. below land surface measured on **8/30/00**Pump test data: Well water was **NA** ft. after **NA** hours pumping **NA** gpmEst. Yield **NA** gpm: Well water was **NA** ft. after **NA** hours pumping **NA** gpmBore Hole Diameter **8** in. to **23** ft. and **23** in. to **23** ft.

WELL WATER TO BE USED AS: 5 Public water supply 8 Air conditioning 11 Injection well

1 Domestic 3 Feedlot 6 Oil field water supply 9 Dewatering 12 Other (Specify below)

2 Irrigation 4 Industrial 7 Lawn and garden only **10** Monitoring well

Was a chemical/bacteriological sample submitted to Department? Yes.....No.....; If yes, mo/day/yr sample was submitted

Water Well Disinfected? Yes No ☒

5 TYPE OF BLANK CASING USED:

1 Steel 3 RMP (SR)

2 PVC 4 ABSBlank casing diameter **2** in. to **8** ft. Dia **8** in. to **8** ft. Dia **8** in. to **8** ft.Casing height above land surface **0** in. weight **0** lbs./ft. Wall thickness or gauge No. **Sch. 40**

TYPE OF SCREEN OR PERFORATION MATERIAL

1 Steel 3 Stainless steel

2 Brass 4 Galvanized steel

5 Fiberglass

6 Concrete tile

7 PVC

8 RMP (SR)

9 ABS

10 Asbestos-cement

11 Other (specify)

12 None used (open hole)

SCREEN OR PERFORATION OPENINGS ARE:

1 Continuous slot

2 Louvered shutter

3 Mill slot

4 Key punched

5 Gauzed wrapped

6 Wire wrapped

7 Torch cut

8 Saw cut

9 Drilled holes

10 Other (specify)

11 None (open hole)

SCREEN-PERFORATED INTERVALS: From **8** ft. to **23** ft. From **8** ft. to **23** ft. From **8** ft. to **23** ft.GRAVEL PACK INTERVALS: From **7** ft. to **23** ft. From **7** ft. to **23** ft. From **7** ft. to **23** ft.From **7** ft. to **23** ft. From **7** ft. to **23** ft. From **7** ft. to **23** ft.7 CONTRACTOR'S OR LANDOWNER'S CERTIFICATION: This water well was **(1)** constructed, **(2)** reconstructed, or **(3)** plugged under my jurisdictionand was completed on (mo/day/year) **8/30/00** and this record is true to the best of my knowledge and belief.Kansas Water Well Contractor's License No. **527** This Water Well Record was completed on (mo/day/yr) **9/26/00**under the business name of **GeoCore Services, Inc.** by (signature) *Don Hall*