

1 LOCATION OF WATER WELL:	Fraction	Section Number	Township Number	Range Number
County: Barton	SE ¼ SE ¼ SE ¼	30	T 19 S	R 12 E/W

Distance and direction from nearest town or city street address of well if located within city?

~3.5 mi E of Great Bend on Barton County Rd

2 WATER WELL OWNER: Rice Engineering Corporation


RR#, St. Address, Box # : 1030 Andrews Hwy, Suite 200

City, State, ZIP Code : Midland, Texas 79701-3872

Board of Agriculture, Division of Water Resources

Application Number:

3 LOCATE WELL'S LOCATION WITH AN "X" IN SECTION BOX:

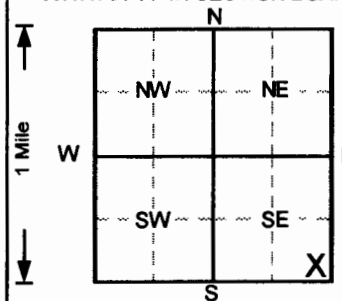

4 DEPTH OF COMPLETED WELL 17.8 ft ELEVATION:

Depth(s) Groundwater Encountered 1. ft 2. ft 3. ft

WELL'S STATIC WATER LEVEL ft below land surface measured on mo/day/yr

Pump test data: Well water was NA ft after hours pumping gpm

Est. Yield NA gpm: Well water was ft after hours pumping gpm

Bore Hole Diameter 8 in. to 18 ft, and in. to ft

WELL WATER TO BE USED AS: 5 Public water supply 8 Air conditioning 11 Injection well

1 Domestic 3 Feedlot 6 Oil field water supply 9 Dewatering 12 Other (Specify below)

2 Irrigation 4 Industrial 7 Lawn and garden only 10 Monitoring well

Was a chemical/bacteriological sample submitted to Department? Yes No ✓; If yes, mo/day/yr sample was submitted

Water Well Disinfection? Yes No ✓

5 TYPE OF BLANK CASING USED:

1 Steel 3 RMP (SR) 5 Wrought iron 8 Concrete tile CASING JOINTS: Glued Clamped

2 PVC 4 ABS 6 Asbestos-Cement 9 Other (specify below) Welded

Blank casing diameter 2 in. to 7.8 ft, Dia in. to ft, Dia in. to ft

Casing height above land surface in., weight lbs./ft. Wall thickness or gauge No. Sch. 40

TYPE OF SCREEN OR PERFORATION MATERIAL

1 Steel 3 Stainless steel 5 Fiberglass 7 PVC 10 Asbestos-cement

2 Brass 4 Galvanized steel 6 Concrete tile 8 RMP (SR) 11 Other (specify)

SCREEN OR PERFORATION OPENINGS ARE: 5 Gauzed wrapped 8 Saw cut 11 None (open hole)

1 Continuous slot 3 Mill slot 6 Wire wrapped 9 Drilled holes

2 Louvered shutter 4 Key punched 7 Torch cut 10 Other (specify)

SCREEN-PERFORATED INTERVALS: From 7.8 ft to 17.8 ft, From ft to ft

From ft to ft, From ft to ft

GRAVEL PACK INTERVALS: From 6.7 ft to 17.8 ft, From ft to ft

From ft to ft, From ft to ft

6 GROUT MATERIAL: 1 Neat cement 2 Cement grout 3 Bentonite 4 Other Concrete

Grout intervals: From 0 ft to 0.5 ft, From 0.5 ft to 6.7 ft, From ft to ft

What is the nearest source of possible contamination:

1 Septic tank 4 Lateral lines 7 Pit privy 10 Livestock pens 14 Abandoned water well

2 Sewer lines 5 Cess pool 8 Sewage lagoon 11 Fuel storage 15 Oil well/Gas well

3 Watertight sewer lines 6 Seepage pit 9 Feedyard 12 Fertilizer storage 16 Other (specify below)

Direction from well? How many feet?

FROM TO LITHOLOGIC LOG FROM TO PLUGGING INTERVALS

0 2 Clay, silty, Black

2 7 Clay, silty, tr. sand, Dark Brown

7 10 Clay, silty, sandy, Brown

10 12 Clay, v. silty, v. sandy, Lt. Brown

12 15 Sand, m-c, clayey, Dark Brown

15 18 Sand, m-c,

INSTRUCTIONS: Use typewriter or ball point pen. PLEASE PRESS FIRMLY and PRINT clearly. Please fill in blanks, underline or circle the correct answers. Send top three copies to Kansas Department of Health and Environment, Bureau of Water, Topeka, Kansas 66620-0001. Telephone: 913-296-5545. Send one to WATER WELL OWNER and retain one for your records.