

1 LOCATION OF WATER WELL: County: BARTON	Fraction NE NE 1/4 1/4	Section Number 2932	Township Number T 19 S	Range Number R 13 E/W
--	---	----------------------------	-------------------------------	------------------------------

Distance and direction from nearest town or city street address of well if located within city?

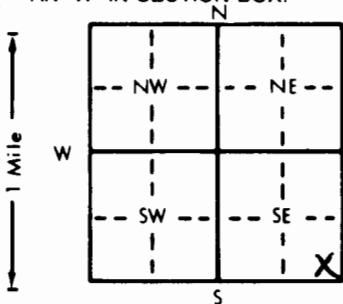
2723 ~~2716~~ 10TH ST GREAT BEND**PW**2 WATER WELL OWNER: **THE MUSKET CORP.**RR#, St. Address, Box #: **BOX 26210**

Board of Agriculture, Division of Water Resources

City, State, ZIP Code: **OKLAHOMA CITY, OK. 73126**

Application Number:

3 LOCATE WELL'S LOCATION WITH AN "X" IN SECTION BOX:

4 DEPTH OF COMPLETED WELL: **25** ft.ELEVATION: **1849.39**Depth(s) Groundwater Encountered 1. **8.5** ft. 2. **10-10-95** ft.WELL'S STATIC WATER LEVEL **9.43** ft. below land surface measured on mo/day/yr **9-28-95**

Pump test data: Well water was _____ ft. after _____ hours pumping _____ gpm

Est. Yield _____ gpm: Well water was _____ ft. after _____ hours pumping _____ gpm

Bore Hole Diameter **14** in. to _____ ft., and _____ in. to _____ ft.

WELL WATER TO BE USED AS: 5 Public water supply 8 Air conditioning 11 Injection well

1 Domestic 3 Feedlot 6 Oil field water supply 9 Dewatering **(2 Other) (Specify below)**2 Irrigation 4 Industrial 7 Lawn and garden only 10 Monitoring well **PUMP TEST**Was a chemical/bacteriological sample submitted to Department? Yes _____ No **X**; If yes, mo/day/yr sample was submitted _____ Water Well Disinfected? Yes _____ No **X**

5 TYPE OF BLANK CASING USED:

- 1 Steel 3 RMP (SR)
(2 PVC) 4 ABS

5 Wrought iron

8 Concrete tile

CASING JOINTS: Glued _____ Clamped _____

6 Asbestos-Cement

9 Other (specify below)

Welded _____

7 Fiberglass

(Threaded)Blank casing diameter **5** in. to _____ ft., Dia _____ in. to _____ ft., Dia _____ in. to _____ ft.Casing height above land surface **FLUSH** in. weight **2.00** lbs./ft. Wall thickness or gauge No. **250**

TYPE OF SCREEN OR PERFORATION MATERIAL:

- 1 Steel 3 Stainless steel
2 Brass 4 Galvanized steel

5 Fiberglass

(1 PVC)

10 Asbestos-cement

6 Concrete tile

8 RMP (SR)

11 Other (specify) _____

9 ABS

12 None used (open hole)

SCREEN OR PERFORATION OPENINGS ARE:

- 1 Continuous slot **(3 Mill slot)**
2 Louvered shutter 4 Key punched

5 Gauzed wrapped

8 Saw cut

11 None (open hole)

6 Wire wrapped

9 Drilled holes

7 Torch cut

10 Other (specify) _____

SCREEN-PERFORATED INTERVALS: From **5** ft. to **20** ft. From _____ ft. to _____ ft.

From _____ ft. to _____ ft. From _____ ft. to _____ ft.

GRAVEL PACK INTERVALS: From **3** ft. to **25** ft. From _____ ft. to _____ ft.

From _____ ft. to _____ ft. From _____ ft. to _____ ft.

6 GROUT MATERIAL:

1 Neat cement

2 Cement grout

(3 Bentonite)

4 Other _____

Grout Intervals: From **1.5** ft. to **3** ft. From _____ ft. to _____ ft. From _____ ft. to _____ ft.

What is the nearest source of possible contamination:

- 1 Septic tank 4 Lateral lines

7 Pit privy

10 Livestock pens

14 Abandoned water well

2 Sewer lines

5 Cess pool

8 Sewage lagoon

(11 Fuel storage)

15 Oil well/Gas well

3 Watertight sewer lines 6 Seepage pit

9 Feedyard

12 Fertilizer storage

16 Other (specify below)

13 Insecticide storage

Direction from well? **NORTH SOUTH**How many feet? **75'**

FROM	TO	LITHOLOGIC LOG	FROM	TO	PLUGGING INTERVALS
0	6	CONCRETE, CLAY, VERY SILTY			
		SOME SAND, FINE TO MEDIUM			
6	17	SAND, MEDIUM TO COARSE			
		POORLY GRADED, FINE GRAVEL			
		CLAY, VERY SILTY			
17	25	SAND, MEDIUM TO VERY COARSE			
		POORLY GRADED w/ FINE GRAVEL			
		CLAY, SLIGHTLY SILTY			

7 CONTRACTOR'S OR LANDOWNER'S CERTIFICATION: This water well was **(1)** constructed, (2) reconstructed, or (3) plugged under my jurisdiction and was completed on (mo/day/year) **10-10-95** and this record is true to the best of my knowledge and belief. KansasWater Well Contractor's License No. **531**This Water Well Record was completed on (mo/day/yr) **11-2-95**under the business name of **GSI**by (signature) **Matt Wolf**