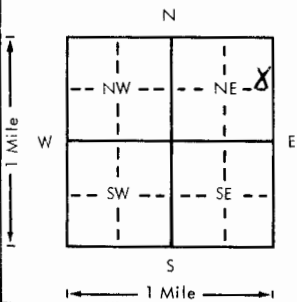


USE TYPEWRITER OR BALL
POINT PEN-PRESS FIRMLY,
PRINT CLEARLY.

WATER WELL RECORD
KSA 82a-1201-1215

Kansas Department of Health and
Environment-Division of Environment
(Water well Contractors)
Topeka, Kansas 66620

1. Location of well:	County Barton	Fraction se 1/4 ne 1/4 ne 1/4	Section number 5	Township number T 19 S	Range number R 13 XW
2. Distance and direction from nearest town or city: 4 north of Great Bend, Ks. Street address of well location if in city:			3. Owner of well: Dale Mitchell R.R. or street: 2918 Geno City, state, zip code: Great Bend, Ks. 67530		
4. Locate with "X" in section below: 			Sketch map: 6. Bore hole dia. 11 in. Completion date Well depth 65 ft. 7-1-79		
5. Type and color of material			7. ☒ Cable tool ☒ Rotary ☐ Driven ☐ Dug ☐ Hollow rod ☐ Jetted ☐ Bored ☐ Reverse rotary		
			8. Use ☒ Domestic ☐ Public supply ☐ Industry ☐ Irrigation ☐ Air conditioning ☐ Stock ☐ Lawn ☐ Oil field water ☐ Other		
			9. Casing: Material pvc Height: Above or below Threaded ☐ Welded ☐ Surface 12 in. RMP ☐ PVC ☒ Weight ☐ lbs./ft. Dia. 5 1/2 in. to 65 ft. depth Wall Thickness: inches or Dia. ☐ in. to ☐ ft. depth gage No. 258		
			10. Screen: Manufacturer's name certainteed Type pvc Dia. 5 1/2 Slot/gauge 1/16 Length 20 Set between 45 ft. and 65 ft. Gravel pack? ☒ Size range of material 1/8-3/4		
			11. Static water level: 37 ft. below land surface Date 6-1-79		
			12. Pumping level below land surfaces: NA ____ ft. after ____ hrs. pumping ____ g.p.m. ____ ft. after ____ hrs. pumping ____ g.p.m. Estimated maximum yield ____ g.p.m.		
			13. Water sample submitted: 6-1-79 ☒ Yes ☐ No Date		
			14. Well head completion: ☒ Pitless adapter 12 inches above grade		
			15. Well grouted? ☒ With: ☒ Neat cement ☐ Bentonite ☐ Concrete Depth: From 0 ft. to 10 ft.		
			16. Nearest source of possible contamination: ft. 130 Direction north type septic tank Well disinfected upon completion? hth Yes ☐ No ☐		
			17. Pump: Manufacturer's name Red Jacket Model number 5cc HP 1/8 Volts 230 Length of drop pipe 50 ft. capacity 10 g.p.m. Type: ☒ Submersible ☐ Turbine ☐ Jet ☐ Reciprocating ☐ Centrifugal ☐ Other		
18. Elevation:			19. Remarks:		
Topography: ☐ Hill ☐ Slope ☒ Upland ☐ Valley			(Use a second sheet if needed)		
			20. Water well contractor's certification: This well was drilled under my jurisdiction and this report is true to the best of my knowledge and belief. Rosencrantz-Bemis 134 Business Box 713 License No. Address Great Bend, Ks. 67530 Signed Fredrick Rodan Date 8/8/79 Authorized representative		

Forward the white, blue and pink copies to the Department of Health and Environment

Form WWC-5