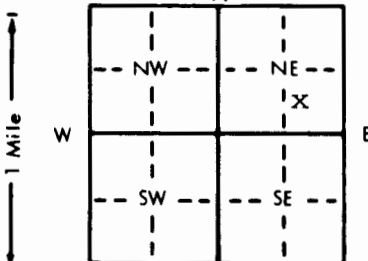


1 LOCATION OF WATER WELL:		Fraction	Section Number	Township Number	Range Number
County: Barton		NW 1/4 NE 1/4 NE 1/4	14	19 S	R 13 XSW
Distance and direction from nearest town or city street address of well if located within city? 1 1/2 mile north and 2 miles east of Great Bend, KS					
2 WATER WELL OWNER: Bob Viles					
RR#, St. Address, Box # : 3213 25th			Board of Agriculture, Division of Water Resources		
City, State, ZIP Code : Great Bend, KS 67530			Application Number: not required		
3 LOCATE WELL'S LOCATION WITH AN "X" IN SECTION BOX:		4 DEPTH OF COMPLETED WELL: 205 ft. ELEVATION: unknown			
		Depth(s) Groundwater Encountered 1. 110 ft. 2. ft. 3. ft.			
		WELL'S STATIC WATER LEVEL 110 ft. below land surface measured on mo/day/yr 2-17-84			
		Pump test data: Well water was not checked ft. after hours pumping gpm			
		Est. Yield unknown gpm: Well water was ft. after hours pumping gpm			
		Bore Hole Diameter 8 1/2 in. to 205 ft., and in. to ft.			
WELL WATER TO BE USED AS: 5 Public water supply 8 Air conditioning 11 Injection well					
1 Domestic 3 Feedlot 6 Oil field water supply 9 Dewatering 12 Other (Specify below)					
2 Irrigation 4 Industrial 7 Lawn and garden only 10 Observation well					
Was a chemical/bacteriological sample submitted to Department? Yes No XX; If yes, mo/day/yr sample was submitted					
Water Well Disinfected? Yes XX No					
5 TYPE OF BLANK CASING USED:					
1 Steel 3 RMP (SR) 5 Wrought iron 8 Concrete tile CASING JOINTS: Glued X Clamped					
2 PVC 4 ABS 6 Asbestos-Cement 9 Other (specify below) Welded					
7 Fiberglass Threaded					
Blank casing diameter 5 in. to 155 ft., Dia. in. to ft., Dia. in. to ft.					
Casing height above land surface 24 in., weight 2.277 lbs./ft. Wall thickness or gauge No. 214					
TYPE OF SCREEN OR PERFORATION MATERIAL:					
1 Steel 3 Stainless steel 5 Fiberglass 7 PVC 10 Asbestos-cement					
2 Brass 4 Galvanized steel 6 Concrete tile 8 RMP (SR) 11 Other (specify)					
12 None used (open hole)					
SCREEN OR PERFORATION OPENINGS ARE:					
1 Continuous slot 3 Mill slot 5 Gauzed wrapped 8 Saw cut 11 None (open hole)					
2 Louvered shutter 4 Key punched 6 Wire wrapped 9 Drilled holes					
7 Torch cut 10 Other (specify)					
SCREEN-PERFORATED INTERVALS: From 155 ft. to 205 ft., From ft. to ft.					
From ft. to ft., From ft. to ft.					
GRAVEL PACK INTERVALS: From 20 ft. to 205 ft., From ft. to ft.					
From ft. to ft., From ft. to ft.					
ANNULAR FILL From 10 ft. to 16 ft., From ft. to ft.					
6 GROUT MATERIAL: 1 Neat cement 2 Cement grout 3 Bentonite 4 Other					
Grout Intervals: From 0 ft. to 10 ft., From 16 ft. to 20 ft., From ft. to ft.					
What is the nearest source of possible contamination:					
1 Septic tank 4 Lateral lines 7 Pit privy 10 Livestock pens 14 Abandoned water well					
2 Sewer lines 5 Cess pool 8 Sewage lagoon 11 Fuel storage 15 Oil well/Gas well					
3 Watertight sewer lines 6 Seepage pit 9 Feedyard 12 Fertilizer storage 16 Other (specify below) FIELD					
13 Insecticide storage					
Direction from well? all How many feet?					
FROM TO LITHOLOGIC LOG FROM TO LITHOLOGIC LOG					
0 72 Topsoil & brown clay					
72 128 Gray & yellow Dakota clay					
128 135 Sandstone					
135 146 Gray & red Dakota clay					
146 150 Sandstone					
150 160 Gray Dakota clay w/real hard streak @ 156'					
160 205 Soft brown sandstone					
7 CONTRACTOR'S OR LANDOWNER'S CERTIFICATION: This water well was (1) constructed, (2) reconstructed, or (3) plugged under my jurisdiction and was completed on (mo/day/year) 2-17-84 and this record is true to the best of my knowledge and belief. Kansas					
Water Well Contractor's License No. 185 This Water Well Record was completed on (mo/day/yr) 2-20-84					
under the business name of CLARKE WELL & EQ., INC. by (signature) Paul W. Clarke					
INSTRUCTIONS: Use typewriter or ball point pen, PLEASE PRESS FIRMLY and PRINT clearly. Please fill in blanks, underline or circle the correct answers. Send top three copies to Kansas Department of Health and Environment, Division of Environment, Environmental Geology Section, Topeka, KS 66620. Send one to WATER WELL OWNER and retain one for your records.					