USE TYPEWRITER OR BALL POINT PEN-PRESS FIRMLY, PRINT CLEARLY.

WATER WELL RECORD
KSA 82a-1201-1215

Kansas Department of Health and Environment-Division of Environment
(Water well Contractors)
Topeka, Kansas 66620

1. Location of well:	County	Fraction	Section number	Township number	Range number
	Barton	NW 1/4 NE 1/4 NE 1/4	14	T 19 S	R 13 E/W

2. Distance and direction from nearest town or city:
4 miles NE of Great Bend, Ks
Street address of well location if in city:

3. Owner of well: Robert Osborn
R.R. or street: All Season's Mobile Park
City, state, zip code: Great Bend, KS 67530

4. Locate with "X" in section below: Sketch map:

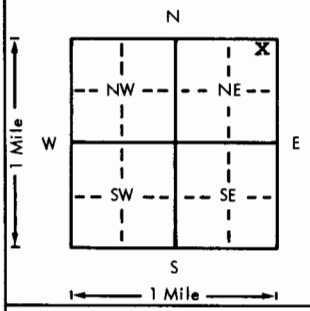

6. Bore hole dia. 9 in. Completion date 7-2-76
Well depth 240 ft.

7. __ Cable tool X Rotary __ Driven __ Dug
__ Hollow rod __ Jetted __ Bored __ Reverse rotary

8. Use: X Domestic __ Public supply __ Industry
__ Irrigation __ Air conditioning __ Stock
__ Lawn __ Oil field water __ Other

9. Casing: Material Styrene Weight: Above or below
Threaded ___ Welded X Surface 12 in.
RMP ___ PVC ___ Weight 1.5 lbs./ft.
Dia. 5 in. to 180 ft. depth Wall Thickness: inches or
Dia. ___ in. to ___ ft. depth gage No. 200#

5. Type and color of material	From	To
top soil	0	4
BR → brown clay & limestone	4	65
Dakota clay, and thin sandstone at 133 & 153	65	176
Dakota clay & hard sandstone streaks	176	202
Sandstone & Dakota clay streaks	202	220
sandstone	220	238

(Use a second sheet if needed)

10. Screen: Manufacturer's name Jess & Lowell
Type Styrene 200 Dia. 5"
Slot/gauze 1/8 Length 60
Set between 180 ft. and 240 ft.
___ ft. and ___ ft.
Gravel pack? yes Size range of material 3/8-200

11. Static water level: mo./day/yr.
103 ft. below land surface Date 6-25-76

12. Pumping level below land surfaces: N/C
___ ft. after ___ hrs. pumping ___ g.p.m.
___ ft. after ___ hrs. pumping ___ g.p.m.
Estimated maximum yield ___ g.p.m.

13. Water sample submitted: mo./day/yr.
___ Yes X No Date ___

14. Well head completion:
___ Pitless adapter 12 Inches above grade

15. Well grouted? yes
With: X Neat cement ___ Bentonite ___ Concrete
Depth: From 0 ft. to 10 ft.

16. Nearest source of possible contamination:
NONE KNOWN
ft. ___ Direction ___ Type ___
Well disinfected upon completion? X Yes ___ No

17. Pump: ___ Not installed
Manufacturer's name Berkeley
Model number 4BL-15 HP 1 Volts 230
Length of drop pipe 168 ft. capacity 15 g.p.m.
Type:
X Submersible ___ Turbine
___ Jet ___ Reciprocating
___ Centrifugal ___ Other

T 19 R 13 E/W Sec 14 1/4 1/4 1/4 1/4 NE NE

18. Elevation:
Topography:
___ Hill
___ Slope
___ Upland
___ Valley

19. Remarks:

20. Water well contractor's certification:
This well was drilled under my jurisdiction and this report is true to the best of my knowledge and belief.
Clarke Well [redacted] & Eq. Inc. 185
Business name License No.
Address Great Bend, KS 67530
Signed [signature] Date 7-7-76
Authorized representative

Forward the white, blue and pink copies to the Department of Health and Environment

Form WWC-5

MI-1023