USE TYPEWRITER OR BALL POINT PEN-PRESS FIRMLY, PRINT CLEARLY.

WATER WELL RECORD
KSA 82a-1201-1215

Kansas Department of Health and Environment-Division of Environment
(Water well Contractors)
Topeka, Kansas 66620

1. Location of well:	County	Fraction	Section number	Township number	Range number
	Barton	NE 1/4 SE 1/4 NE 1/4	14	T 19 S	R 13 E/W

2. Distance and direction from nearest town or city: 2N 3E
Street address of well location if in city: Great Bend, KS

3. Owner of well: Walt Sadler
R.R. or street: R3
City, state, zip code: Great Bend, KS

4. Locate with "X" in section below:

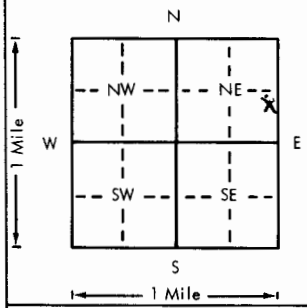

Sketch map:

X. Bore hole dia. 8 in. Completion date
Well depth 232 ft. 6-15-77

7. __ Cable tool X Rotary __ Driven __ Dug
__ Hollow rod __ Jetted __ Bored __ Reverse rotary

8. Use: X Domestic __ Public supply __ Industry
__ Irrigation __ Air conditioning __ Stock
__ Lawn __ Oil field water __ Other

9. Casing: Material ____ Height: Above or below
Threaded ____ Welded ____ Surface 12 in.
RMP ____ PVC X Weight ____ lbs./ft.
Dia. 5 in. to 232 ft. depth Wall Thickness: inches or
Dia. ____ in. to ____ ft. depth gage No. Sch 40

5. Type and color of material	From	To
Top Soil-Clay	0	20
Clay	20	190
Sand-Rock	190	232

(Use a second sheet if needed)

10. Screen: Manufacturer's name MPI
Type PVC Dia. 5
Slot/gauze 1/16" Length 30
Set between 202 ft. and 232 ft.
____ ft. and ____ ft.
Gravel pack? X Size range of material 1/8-3/4"

11. Static water level: mo./day/yr.
65 ft. below land surface Date 6-15-77

12. Pumping level below land surfaces:
____ ft. after ____ hrs. pumping ____ g.p.m.
____ ft. after ____ hrs. pumping ____ g.p.m.
Estimated maximum yield 30 g.p.m.

13. Water sample submitted: mo./day/yr.
__ Yes X No Date

14. Well head completion:
__ Pitless adapter 12 Inches above grade

15. Well grouted? X
With: X Neat cement __ Bentonite __ Concrete
Depth: From 0 ft. to 10 ft.

16. Nearest source of possible contamination: Septic
ft. 70 Direction W Type Tank
Well disinfected upon completion? X Yes __ No

17. Pump: __ Not installed
Manufacturer's name Goulds
Model number 13EM HP 2 Volts 230
Length of drop pipe 205 ft. capacity 15 g.p.m.
Type:
X Submersible __ Turbine
__ Jet __ Reciprocating
__ Centrifugal __ Other

18. Elevation:
Topography:
X Hill
__ Slope
__ Upland
__ Valley

19. Remarks:

20. Water well contractor's certification:
This well was drilled under my jurisdiction and this report is true to the best of my knowledge and belief.
Business name Kelly's Water Well License No. 186
Address R2 Great Bend, KS
Signed Kelly Price Date 7-22-78
Authorized representative

T 19 R 13 W Sec 14 1/4 1/4 1/4 1/4 NE SENE

Forward the white, blue and pink copies to the Department of Health and Environment

Form WWC-5

MI-1023