USE TYPEWRITER OR BALL POINT PEN-PRESS FIRMLY, PRINT CLEARLY.

WATER WELL RECORD
KSA 82a-1201-1215

Kansas Department of Health and Environment-Division of Environment
(Water well Contractors)
Topeka, Kansas 66620

1. Location of well:	County	Fraction	Section number	Township number	Range number
	Barton	NW 1/4 SE 1/4 NW 1/4	21	T 19 (S)	R 13 (E/W)

2. Distance and direction from nearest town or city: 1 mile North
Street address of well location if in city: Gt. Bend, Ks

3. Owner of well: Richard Wegele
R.R. or street: Rt 4
City, state, zip code: Great Bend, Ks. 67640

4. Locate with "X" in section below: Sketch map: service road

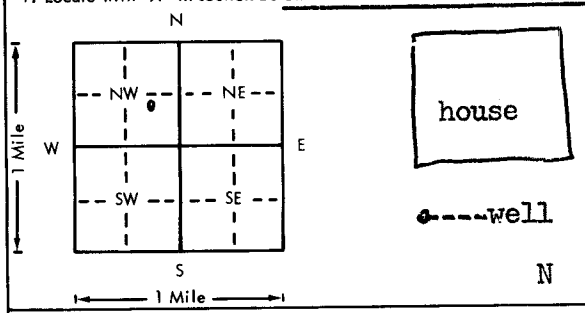

5. Type and color of material	From	To
Top soil	0	4
clay	4	30
fine sand	30	52
med. sand	52	70
Shale	70	75

(Use a second sheet if needed)

6. Bore hole dia. 9 in. Completion date 5-10-79
Well depth 75 ft.

7. __ Cable tool X Rotary __ Driven __ Dug
__ Hollow rod __ Jetted __ Bored __ Reverse rotary

8. Use: X Domestic __ Public supply __ Industry
__ Irrigation __ Air conditioning __ Stock
__ Lawn __ Oil field water __ Other

9. Casing: Material PVC
Threaded ___ Welded X
RMP ___ PVC X
Dia. 5 in. to 75 ft. depth
Dia. ___ in. to ___ ft. depth
Height: Above or below
Surface 24 in.
Weight 200 lbs./ft.
Wall Thickness: inches or gage No. 126

10. Screen: Manufacturer's name Jet Stream
Type 200 Dia. 5"
Slot gauze .031 Length 75'
Set between 65 ft. and 75 ft.
___ ft. and ___ ft.
Gravel pack? X Size range of material 1/4-1/2

11. Static water level: mo./day/yr.
40 ft. below land surface Date ___

12. Pumping level below land surfaces:
60 ft. after 2 hrs. pumping 10 g.p.m.
___ ft. after ___ hrs. pumping ___ g.p.m.
Estimated maximum yield 10 g.p.m.

13. Water sample submitted: mo./day/yr.
__ Yes X No Date ___

14. Well head completion:
X Pitless adapter ___ Inches above grade

15. Well grouted? X
With: X Neat cement __ Bentonite __ Concrete
Depth: From 4 ft. to 14 ft.

16. Nearest source of possible contamination: NONE
ft. ___ Direction ___ Type ___
Well disinfected upon completion? X Yes __ No

17. Pump: __ Not installed
Manufacturer's name F+W
Model number SBAR HP 1/2 Volts 230
Length of drop pipe 60 ft. capacity 10 g.p.m.
Type:
X Submersible __ Turbine
__ Jet __ Reciprocating
__ Centrifugal __ Other

18. Elevation:
Topography:
__ Hill
V Slope
__ Upland
__ Valley

19. Remarks:

20. Water well contractor's certification:
This well was drilled under my jurisdiction and this report is true to the best of my knowledge and belief.
Kent Water Well Serv. inc
Business name License No.
Address E Hiway 40 Hoxp. Ks.
Signed [signature] Date 6-5-79
Authorized representative

T 19 R 13 (W) Sec 21 1/4 NW 1/4 SE 1/4 NW 1/4

Forward the white, blue and pink copies to the Department of Health and Environment

Form WWC-5

MI-1023