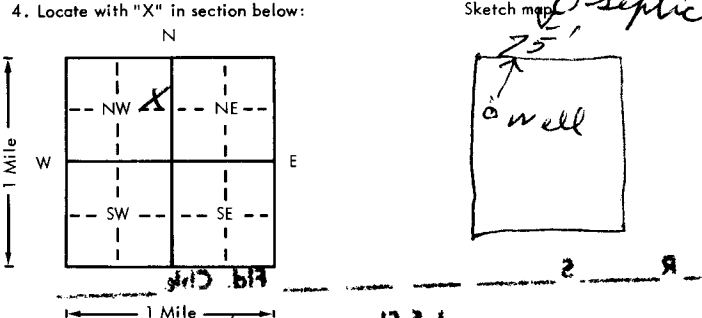


USE TYPEWRITER OR BALL
POINT PEN-PRESS FIRMLY,
PRINT CLEARLY.

WATER WELL RECORD
KSA 82a-1201-1215

Kansas Department of Health and
Environment-Division of Environment
(Water well Contractors)
Topeka, Kansas 66620

1. Location of well: County <u>Barton</u> Fraction <u>SE NE NW 21</u> Section number <u>195</u> Township number <u>North main</u> Range number <u>13</u>	
2. Distance and direction from nearest town or city: <u>1 North of Great Bend, KS.</u> Street address of well location if in city: <u>Stevens Engine Co</u> City, state, zip code: <u>Great Bend KS</u>	
4. Locate with "X" in section below: 	
6. Bore hole dia. <u>2</u> in. Completion date <u>Jan 27-77</u> Well depth <u>67</u> ft.	
7. Cable tool ☒ Rotary ☐ Driven ☐ Dug ☐ Hollow rod ☐ Jetted ☐ Bored ☐ Reverse rotary	
8. Use: ☐ Domestic ☐ Public supply ☒ Industry ☐ Irrigation ☐ Air conditioning ☐ Stock ☐ Lawn ☐ Oil field water ☐ Other	
9. Casing: Material <u>Plastic</u> Height: <u>Above</u> or below Threaded ☐ Welded ☒ Surface <u>12</u> in. RMP ☐ PVC ☒ Weight <u>267.3</u> lbs./ft. Dia. <u>4</u> in. to <u>67</u> ft. depth Wall Thickness: inches or Dia. <u>4</u> in. to <u>67</u> ft. depth Gauge No. <u>40</u>	
10. Screen: Manufacturer's name <u>Self made</u> Type <u>PVC</u> Dia. <u>4</u> Slot/gauze <u>1/8</u> Length <u>10</u> Set between <u>52</u> ft. and <u>67</u> ft. Gravel pack? ☒ Size range of material <u>5-1/4</u>	
11. Static water level: <u>16</u> ft. below land surface Date <u>1-27-77</u> mo./day/yr.	
12. Pumping level below land surfaces: ____ ft. after ____ hrs. pumping ____ g.p.m. ____ ft. after ____ hrs. pumping ____ g.p.m. Estimated maximum yield ____ g.p.m.	
13. Water sample submitted: ____ mo./day/yr. Yes ☐ No ☒ Date ____	
14. Well head completion: <u>12</u> Pitless adapter ____ Inches above grade	
15. Well grouted? <u>yes</u> With: ☒ Neat cement ☐ Bentonite ☐ Concrete Depth: From <u>0</u> ft. to <u>10</u> ft.	
16. Nearest source of possible contamination: ft. <u>15</u> Direction <u>west</u> Type <u>septic</u> Well disinfected upon completion? ☒ Yes ☐ No	
17. Pump: ☒ Not installed Manufacturer's name ____ Model number ____ HP ____ Volts ____ Length of drop pipe ____ ft. capacity ____ g.p.m. Type: ☐ Submersible ☐ Turbine ☐ Jet ☐ Reciprocating ☐ Centrifugal ☐ Other	
18. Elevation: Topography: ☐ Hill ☒ Slope ☐ Upland ☐ Valley	
19. Remarks: <u>1996</u>	
20. Water well contractor's certification: This well was drilled under my jurisdiction and this report is true to the best of my knowledge and belief. <u>Myers Water Well</u> Business name <u>Great Bend KS 143</u> License No. <u>143</u> Address <u>Great Bend KS</u> Signed <u>P. Myers</u> Date <u>1-27-77</u> Authorized representative	

Forward the white, blue and pink copies to the Department of Health and Environment

Form WWC-5