USE TYPEWRITER OR BALL POINT PEN-PRESS FIRMLY, PRINT CLEARLY.

WATER WELL RECORD
KSA 82a-1201-1215

Kansas Department of Health and Environment-Division of Environment
(Water well Contractors)
Topeka, Kansas 66620

1. Location of well:	County	Fraction	Section number	Township number	Range number
	Barton	1/4 SW 1/4 SW 1/4	26	T 19 S	R 13 E/W

2. Distance and direction from nearest town or city:
1-E 300 ft.-N ¼-E of Great Bend, Ks.
Street address of well location if in city:

3. Owner of well: Ralph Haneke
R.R. or street: 2008 Harrison
City, state, zip code: Great Bend, Ks. 67530

4. Locate with "X" in section below:

Sketch map:

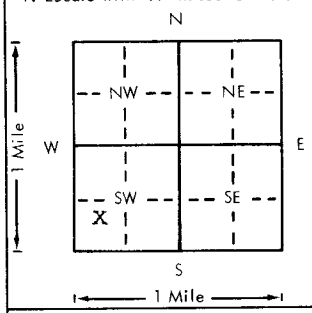

6. Bore hole dia. 10 in. Completion date 12-28-78
Well depth 60 ft. ~~XXX8-78 XXX~~

7. __ Cable tool X Rotary __ Driven __ Dug
__ Hollow rod __ Jetted __ Bored __ Reverse rotary

8. Use: X Domestic __ Public supply __ Industry
__ Irrigation __ Air conditioning __ Stock
__ Lawn __ Oil field water __ Other

9. Casing: Material pvc
Threaded ___ Welded ___
RMP ___ PVC X
Dia. 5¼ in. to 60 ft. depth
Dia. ___ in. to ___ ft. depth
Height: Above or ~~below~~
Surface 18 in.
Weight ___ lbs./ft.
Wall Thickness: inches or gage No. .258

5. Type and color of material	From	To
sandy top soil	0	3
clay	3	16
sand	16	32
clay	32	34
sand & gravel	34	60
clay	60	

(Use a second sheet if needed)

10. Screen: Manufacturer's name CertainTeed
Type pvc Dia. ___
Slot ~~size~~ 1/16 Length 20
Set between 60 ft. and 40 ft.
___ ft. and ___ ft.
Gravel pack? X Size range of material 3/4 3/8

11. Static water level: mo./day/yr.
19 ft. below land surface Date 10-18-78

12. Pumping level below land surfaces:
19 ft. after 1 hrs. pumping 100 g.p.m.
___ ft. after ___ hrs. pumping ___ g.p.m.
Estimated maximum yield 200 g.p.m.

13. Water sample submitted: mo./day/yr.
X Yes ___ No Date 10-18-78

14. Well head completion:
___ Pitless adapter ___ Inches above grade

15. Well grouted? X
With: X Neat cement ___ Bentonite ___ Concrete
Depth: From 0 ft. to 12 ft.

16. Nearest source of possible contamination:
ft. 125 Direction east Type septic
Well disinfected upon completion? hth Yes ___ No

17. Pump: ___ Not installed
Manufacturer's name Red Jacket
Model number 6DC HP 1½ Volts 230
Length of drop pipe 42 ft. capacity 28 g.p.m.
Type:
X Submersible ___ Turbine
___ Jet ___ Reciprocating
___ Centrifugal ___ Other

18. Elevation:

Topography:
___ Hill
___ Slope
X Upland
___ Valley

19. Remarks:

20. Water well contractor's certification:
This well was drilled under my jurisdiction and this report is true to the best of my knowledge and belief.
Rosencrantz-Remis 134
Business name License No.
Address Great BEnd, Ks. 67530
Signed Sandy Kilgore Date 1-8-79
Authorized representative

T 19 R 13 E/W Sec 26 1/4 SW 1/4 SW 1/4

Forward the white, blue and pink copies to the Department of Health and Environment

Form WWC-5

MI-1023