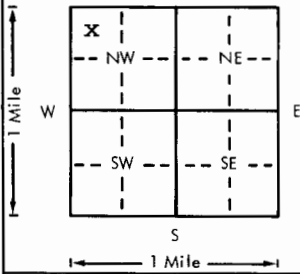


USE TYPEWRITER OR BALL
POINT PEN-PRESS FIRMLY,
PRINT CLEARLY.

WATER WELL RECORD
KSA 82a-1201-1215

Kansas Department of Health and
Environment-Division of Environment
(Water well Contractors)
Topeka, Kansas 66620

1. Location of well:		County Barton	Fraction 1/4 NW 1/4 NW 1/4	Section number 28	Township number T 19 S R 13	Range number EW
2. Distance and direction from nearest town or city: Street address of well location if in city: 2500 Shawnee, Great Bend, KS			3. Owner of well: Victor M. Luft R.R. or street: 2500 Shawnee City, state, zip code: Great Bend, KS 67530			
4. Locate with "X" in section below: Sketch map: 			6. Bore hole dia. 9 in. Completion date 4-13-78 Well depth 30 ft.			
5. Type and color of material			7. Cable tool ☐ Rotary ☐ Driven ☐ Dug ☐ Hollow rod ☐ Jetted ☐ Bored ☒ Reverse rotary			
			8. Use: Domestic ☐ Public supply ☐ Industry ☐ Irrigation ☐ Air conditioning ☐ Stock ☐ ☒ Lawn ☐ Oil field water ☐ Other			
			9. Casing: Material Styrene Height: Above or below Threaded ☐ Welded ☒ Surface 12 in. RMP ☐ PVC ☐ Weight 1.5 lbs./ft. Dia. 5 in. to 20 ft. depth Wall Thickness: inches or Dia. ☐ in. to ☐ ft. depth gage No. 200			
			10. Screen: Manufacturer's name Jess & Lowell Type Styrene 200 Dia. 5" Slot gauze 1/8" Length 10' Set between 20 ft. and 30 ft. ft. and ☐ ft. Gravel pack? yes Size range of material 3/8-200			
			11. Static water level: ☐ mo./day/yr. 13'10" ft. below land surface Date 4-13-78			
(Use a second sheet if needed)			12. Pumping level below land surfaces: not checked ☐ ft. after ☐ hrs. pumping ☐ g.p.m. ☐ ft. after ☐ hrs. pumping ☐ g.p.m. Estimated maximum yield ☐ g.p.m.			
			13. Water sample submitted: ☐ mo./day/yr. ☐ Yes ☒ No Date ☐			
			14. Well head completion: ☐ Pitless adapter 12 inches above grade			
			15. Well grouted? yes With: ☒ Neat cement ☐ Bentonite ☐ Concrete Depth: From 0 ft. to 10 ft.			
			16. Nearest source of possible contamination: FIELD ft. ☐ Direction ☐ Type ☐ Well disinfected upon completion? ☒ Yes ☐ No			
18. Elevation: Topography: ☐ Hill ☐ Slope ☐ Upland ☐ Valley			17. Pump: ☒ Not installed Manufacturer's name ☐ Model number ☐ HP ☐ Volts ☐ Length of drop pipe ☐ ft. capacity ☐ g.p.m. Type: ☐ Submersible ☐ Turbine ☐ Jet ☐ Reciprocating ☐ Centrifugal ☐ Other			
			20. Water well contractor's certification: This well was drilled under my jurisdiction and this report is true to the best of my knowledge and belief. Clarke Well & Eq., Inc. 185 Business name License No. Address Great Bend, KS 67530 Signed D. D. Clarke Date 4-14-78 Authorized Representative			
			19. Remarks: 			