USE TYPEWRITER OR BALL POINT PEN-PRESS FIRMLY, PRINT CLEARLY.

WATER WELL RECORD
KSA 82a-1201-1215

Kansas Department of Health and Environment-Division of Environment
(Water well Contractors)
Topeka, Kansas 66620

| 1. Location of well: | County | Fraction | Section number | Township number | Range number |
|---|---|---|---|---|---|
| | Barton | 1/4 NW 1/4 NE 1/4 | 28 | T 19 S | R 13 E/W |

2. Distance and direction from nearest town or city:
Street address of well location if in city: 2427 Shawnee Great Bend, KS

3. Owner of well: Lester Nuss
R.R. or street: 2427 Shawnee
City, state, zip code: Great Bend, KS

4. Locate with "X" in section below:

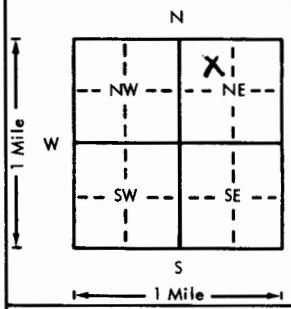


Sketch map:

6. Bore hole dia. 7 in. Completion date 4-21-76
Well depth 72 ft.

7. ___ Cable tool X Rotary ___ Driven ___ Dug
___ Hollow rod ___ Jetted ___ Bored ___ Reverse rotary

8. Use: ___ Domestic ___ Public supply ___ Industry
___ Irrigation ___ Air conditioning ___ Stock
X Lawn ___ Oil field water ___ Other

9. Casing: Material _____ Height: (Above) or below
Threaded ___ Welded ___ Surface 12 in.
RMP ___ PVC X Weight _____ lbs./ft.
Dia. 4 in. to 72 ft. depth Wall Thickness: inches or
Dia. ___ in. to ___ ft. depth gage No. 200#

| 5. Type and color of material | From | To |
|---|---|---|
| Topsoil - Clay | 0 | 11 |
| Sand - Gravel | 11 | 32 |
| Clay | 32 | 48 |
| Sand - Gravel | 48 | 72 |

10. Screen: Manufacturer's name MPI
Type PVC Dia. 4"
Slot/gauze 1/8" Length 20'
Set between 52 ft. and 72 ft.
_____ ft. and _____ ft.
Gravel pack? X Size range of material 1/8 - 3/4"

11. Static water level: mo./day/yr.
12 ft. below land surface Date 4-21-76

12. Pumping level below land surfaces:
_____ ft. after _____ hrs. pumping _____ g.p.m.
_____ ft. after _____ hrs. pumping _____ g.p.m.
Estimated maximum yield 100 g.p.m.

13. Water sample submitted: mo./day/yr.
___ Yes X No Date _____

14. Well head completion:
___ Pitless adapter 12 Inches above grade

15. Well grouted? X
With: X Neat cement ___ Bentonite ___ Concrete
Depth: From 0 ft. to 10 ft.

16. Nearest source of possible contamination:
ft. 70 Direction S Type Sewer
Well disinfected upon completion? X Yes ___ No

17. Pump: ___ Not installed
Manufacturer's name Goulds
Model number 25EL HP 1 Volts 230
Length of drop pipe 40 ft. capacity 25 g.p.m.
Type:
X Submersible ___ Turbine
___ Jet ___ Reciprocating
___ Centrifugal ___ Other

(Use a second sheet if needed)

18. Elevation:

Topography:
___ Hill
___ Slope
___ Upland
X Valley

19. Remarks: 1944

20. Water well contractor's certification:
This well was drilled under my jurisdiction and this report is true to the best of my knowledge and belief.
Kelly's Water Well Serv. 186
Business name License No.
Address R2 Great Bend, KS
Signed Kelly Davis Date 4-24-76
Authorized representative

T 19 R 13 E/W Sec 28 1/4 1/4 1/4 1/4

Forward the white, blue and pink copies to the Department of Health and Environment

Form WWC-5