


1 LOCATION OF WATER WELL:	Fraction	Section Number	Township Number	Range Number
County Barton	SE 1/4 NW 1/4 SE 1/4	28	T 19 S	R 13 E

Distance and direction from nearest town or city street address of well if located within city?

1423 Baker St. in Great Bend, Ks.

2	WATER WELL OWNER:	Harry Schartz	
	RR#, St. Address, Box # :	1423 Baker St.	Board of Agriculture, Division of Water Resources
	City, State, ZIP Code :	Great 1Bend, Ks/	Application Number: 147

3 LOCATE WELL'S LOCATION WITH AN "X" IN SECTION BOX: 4 DEPTH OF COMPLETED WELL: 6.0 ft. ELEVATION:

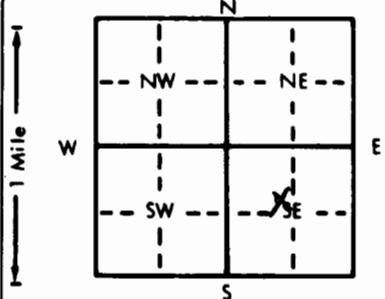

4) DEPTH OF COMPLETED WELL... 6.0 ft. ELEVATION:
 Depth(s) Groundwater Encountered 1. ft. 2. ft. 3. ft.
 WELL'S STATIC WATER LEVEL 2.0 ft. below land surface measured on mo/day/yr ... 4-21-86
 Pump test data: Well water was ft. after hours pumping gpm
 Est. Yield .. 12. gpm: Well water was ft. after hours pumping gpm
 Bore Hole Diameter..... 1.0 .in. to 6.0 ft., and..... .in. to ft.
 WELL WATER TO BE USED AS: 5 Public water supply 8 Air conditioning 11 Injection well
 1 Domestic 3 Feedlot 6 Oil field water supply 9 Dewatering 12 Other (Specify below)
 2 Irrigation 4 Industrial 7 Lawn and garden only 10 Observation well
 Was a chemical/bacteriological sample submitted to Department? Yes.....No.x.....; If yes, mo/day/yr sample was sub-
 mitted Water Well Disinfected? Yes hth No

5	TYPE OF BLANK CASING USED:		5 Wrought iron	8 Concrete tile	CASING JOINTS: Glued Clamped Welded Threaded
	1 Steel	3 RMP (SR)	6 Asbestos-Cement	9 Other (specify below)	
	2 PVC	4 ABS	7 Fiberglass		

Blank casing diameter 5 in. to 40 ft., Dia in. to ft., Dia in. to ft.
Casing height above land surface 18 in., weight lbs./ft. Wall thickness or gauge No. . . . 258.

TYPE OF SCREEN OR PERFORATION MATERIAL:			7 PVC	10 Asbestos-cement
1 Steel	3 Stainless steel	5 Fiberglass	8 RMP (SR)	11 Other (specify)
2 Brass	4 Galvanized steel	6 Concrete tile	9 ABS	12 None used (open hole)

SCREEN OR PERFORATION OPENINGS ARE:		5 Gauzed wrapped	8 Saw cut	11 None (open hole)
1 Continuous slot	3 Mill slot	6 Wire wrapped	9 Drilled holes	
2 Louvered shutter	4 Key punched	7 Torch cut	10 Other (specify)	

SCREEN-PERFORATED INTERVALS:	From . . . 4 0 ft. to 6 0 ft.,	From ft. to ft.
	From ft. to ft.,	From ft. to ft.
GRAVEL PACK INTERVALS:	From 1 0 ft. to 6 0 ft.,	From ft. to ft.
	From ft. to ft.,	From ft. to ft.

6	GROUT MATERIAL:				1 Neat cement	2 Cement grout	3 <u>Bentonite</u>	4 Other
Grout Intervals:		From	0	ft. to	10	ft.	From	ft. to

What is the nearest source of possible contamination:				10 Livestock pens	14 Abandoned water well
1 Septic tank	4 Lateral lines	7 Pit privy	11 Fuel storage	15 Oil well/Gas well	
2 Sewer lines	5 Cess pool	8 Sewage lagoon	12 Fertilizer storage	16 Other (specify below)	
3 Watertight sewer lines	6 Seepage pit	9 Feedyard	13 Insecticide storage		

Direction from well? east How many feet? 51

[illegible]

7 CONTRACTOR'S OR LANDOWNER'S CERTIFICATION: This water well was (1) constructed, (2) reconstructed, or (3) plugged under my jurisdiction and was completed on (mo/day/year) 4-21-86 and this record is true to the best of my knowledge and belief. Kansas Water Well Contractor's License No. 134 This Water Well Record was completed on (mo/day/yr) 7-10-86 under the business name of Rosencrantz-Bemis by (signature) Freddie Robinson

INSTRUCTIONS: Use typewriter or ball point pen. PLEASE PRESS FIRMLY and PRINT clearly. Please fill in blanks, underline or circle the correct answers. Send top three copies to Kansas Department of Health and Environment, Office of Oil Field and Environmental Geology, Regulation and Permitting Section, Topeka, Kansas 66620-7500, Telephone: 913-862-9360. Send one to WATER WELL OWNER and retain one for your records.