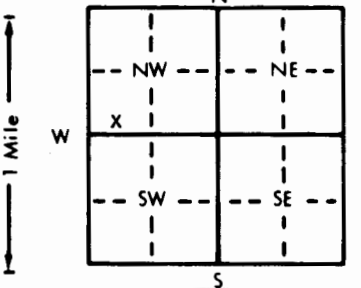


1 LOCATION OF WATER WELL:		Fraction		Section Number		Township Number		Range Number	
County: Barton		SW 1/4 SW 1/4 NW 1/4		28		T 19 S		R 13 E/W	
Distance and direction from nearest town or city street address of well if located within city?									
2506 17th Street, Great Bend, Kansas					Job No. 74-41/4004.01				
2 WATER WELL OWNER: M.L. Midgorden									
RR#, St. Address, Box # : 2506 17th Street									
City, State, ZIP Code : Great Bend, Kansas 67530									
Board of Agriculture, Division of Water Resources									
Application Number:									
3 LOCATE WELL'S LOCATION WITH AN "X" IN SECTION BOX:		4 DEPTH OF COMPLETED WELL: 16 ft. ELEVATION: N/A							
		Depth(s) Groundwater Encountered 1. 10 ft. 2. ft. 3. ft.							
		WELL'S STATIC WATER LEVEL 9.31 ft. below land surface measured on mo/day/yr							
		Pump test data: Well water was ft. after hours pumping gpm							
		Est. Yield gpm: Well water was ft. after hours pumping gpm							
		Bore Hole Diameter 6.5 in. to 16 ft. and in. to ft.							
		WELL WATER TO BE USED AS:							
		5 Public water supply 8 Air conditioning 11 Injection well							
		1 Domestic 3 Feedlot 6 Oil field water supply 9 Dewatering 12 Other (Specify below)							
		2 Irrigation 4 Industrial 7 Lawn and garden only 10 Monitoring well MW-9							
		Was a chemical/bacteriological sample submitted to Department? Yes No X; If yes, mo/day/yr sample was submitted							
		Water Well Disinfected? Yes No X							
5 TYPE OF BLANK CASING USED:									
1 Steel 3 RMP (SR) 5 Wrought iron 8 Concrete tile CASING JOINTS: Glued Clamped									
2 PVC 4 ABS 6 Asbestos-Cement 9 Other (specify below) Welded									
Blank casing diameter 2 in. to 5 ft. Dia. in. to ft. Dia. in. to ft.									
Casing height above land surface flush 0 in., weight lbs./ft. Wall thickness or gauge No. Sch. 40									
TYPE OF SCREEN OR PERFORATION MATERIAL:									
1 Steel 3 Stainless steel 5 Fiberglass 8 RMP (SR) 10 Asbestos-cement									
2 Brass 4 Galvanized steel 6 Concrete tile 9 ABS 11 Other (specify)									
SCREEN OR PERFORATION OPENINGS ARE:									
1 Continuous slot 3 Mill slot 5 Gauzed wrapped 8 Saw cut 11 None (open hole)									
2 Louvered shutter 4 Key punched 6 Wire wrapped 9 Drilled holes									
7 Torch cut 10 Other (specify)									
SCREEN-PERFORATED INTERVALS: From 5.5 ft. to 15.5 ft. From ft. to ft.									
GRAVEL PACK INTERVALS: From 3.5 ft. to 16.0 ft. From ft. to ft.									
6 GROUT MATERIAL: 1 Neat cement 2 Cement grout 3 Bentonite 4 Other									
Grout Intervals: From 1.0 ft. to 3.5 ft. From ft. to ft. From ft. to ft.									
What is the nearest source of possible contamination:									
1 Septic tank 4 Lateral lines 7 Pit privy 10 Livestock pens 14 Abandoned water well									
2 Sewer lines 5 Cess pool 8 Sewage lagoon 11 Fuel storage 15 Oil well/Gas well									
3 Watertight sewer lines 6 Seepage pit 9 Feedyard 12 Fertilizer storage 16 Other (specify below)									
13 Insecticide storage									
Direction from well? West How many feet? 700									
FROM TO LITHOLOGIC LOG FROM TO PLUGGING INTERVALS									
0 3.0 Silty clay; brown									
3.0 4.0 Silty Clay; dark brown									
4.0 7.0 Silty clay; dark gray mottled; orange brown.									
7.0 9.0 Silty clay; as above; moist.									
9.0 11.0 Sand; brown; fine; wet									
11.0 16.0 Sand; mottled; coarse; brown; few gravel; and pebbles saturated.									
7 CONTRACTOR'S OR LANDOWNER'S CERTIFICATION: This water well was (X) constructed, (2) reconstructed, or (3) plugged under my jurisdiction and was completed on (mo/day/year) 6/12/91 and this record is true to the best of my knowledge and belief. Kansas Water Well Contractor's License No. 471 This Water Well Record was completed on (mo/day/yr) 6/26/91 under the business name of HWS Technologies Inc. by (signature)									