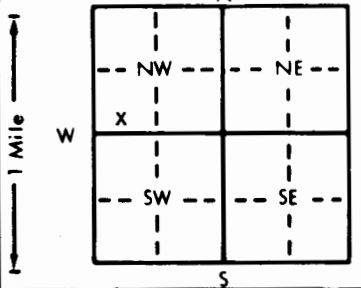


1 LOCATION OF WATER WELL: County: Barton		Fraction SW 1/4 SW 1/4 NW 1/4		Section Number 28	Township Number T 19 S	Range Number R 13 E/WX	
Distance and direction from nearest town or city street address of well if located within city? 2507 Russell Parkway Great Bend, Kansas 41/4004.01	
2 WATER WELL OWNER: City of Great Bend, KS RR#, St. Address, Box #: Great Bend, KS 67530 City, State, ZIP Code: Board of Agriculture, Division of Water Resources Application Number:	
3 LOCATE WELL'S LOCATION WITH AN "X" IN SECTION BOX: 		4 DEPTH OF COMPLETED WELL: 15.5' ft. ELEVATION: N/A Depth(s) Groundwater Encountered 1. 10.0 ft. 2. ft. 3. ft. WELL'S STATIC WATER LEVEL 8.64 ft. below land surface measured on mo/day/yr 6/14/91 Pump test data: Well water was ft. after hours pumping gpm Est. Yield gpm: Well water was ft. after hours pumping gpm Bore Hole Diameter 6.5 in. to 15.5 ft. and in. to ft. WELL WATER TO BE USED AS: 1 Domestic 3 Feedlot 6 Oil field water supply 9 Dewatering 12 Other (Specify below) 2 Irrigation 4 Industrial 7 Lawn and garden only 10 Monitoring well MW-12 Was a chemical/bacteriological sample submitted to Department? Yes No X; If yes, mo/day/yr sample was submitted Water Well Disinfected? Yes No X	
5 TYPE OF BLANK CASING USED: 1 Steel 3 RMP (SR) 5 Wrought iron 8 Concrete tile CASING JOINTS: Glued Clamped 2 PVC 4 ABS 6 Asbestos-Cement 9 Other (specify below) Welded Blank casing diameter 2" in. to 5.0 ft. Dia in. to ft. Dia in. to ft. Casing height above land surface flush in, weight lbs./ft. Wall thickness or gauge No. Sch 40 TYPE OF SCREEN OR PERFORATION MATERIAL: 1 Steel 3 Stainless steel 5 Fiberglass 8 RMP (SR) 10 Asbestos-cement 2 Brass 4 Galvanized steel 6 Concrete tile 9 ABS 11 Other (specify) 12 None used (open hole) SCREEN OR PERFORATION OPENINGS ARE: 1 Continuous slot 2 Mill slot 3 Gauzed wrapped 4 Saw cut 5 None (open hole) 2 Louvered shutter 4 Key punched 7 Wire wrapped 9 Drilled holes 10 Other (specify) SCREEN-PERFORATED INTERVALS: From 5.0 ft. to 15.0 ft. From ft. to ft. GRAVEL PACK INTERVALS: From 3.0 ft. to 15.5 ft. From ft. to ft. From ft. to ft. From ft. to ft.	
6 GROUT MATERIAL: 1 Neat cement 2 Cement grout 3 Bentonite 4 Other Grout Intervals: From 1 ft. to 3.0 ft. From ft. to ft. From ft. to ft. What is the nearest source of possible contamination: 1 Septic tank 4 Lateral lines 7 Pit privy 10 Livestock pens 14 Abandoned water well 2 Sewer lines 5 Cess pool 8 Sewage lagoon 11 Fuel storage 15 Oil well/Gas well 3 Watertight sewer lines 6 Seepage pit 9 Feedyard 12 Fertilizer storage 16 Other (specify below) 13 Insecticide storage Direction from well? WSW How many feet? 700'	
<table border="1"><thead><tr><th>FROM</th><th>TO</th><th>LITHOLOGIC LOG</th><th>FROM</th><th>TO</th><th>PLUGGING INTERVALS</th></tr></thead><tbody><tr><td>0</td><td>3'</td><td>Silty Clay Brown</td><td></td><td></td><td></td></tr><tr><td>3'</td><td>5'</td><td>Silty Clay Light Brown</td><td></td><td></td><td></td></tr><tr><td>5'</td><td>7'</td><td>Silty Clay Dark Gray Mottled Orange-brown</td><td></td><td></td><td></td></tr><tr><td>7'</td><td>10'</td><td>Silty Sand Fine, Brown, Moist</td><td></td><td></td><td></td></tr><tr><td>10'</td><td>12'</td><td>Sand medium-coarse, Brown mottled orange-brown, wet</td><td></td><td></td><td></td></tr><tr><td>12'</td><td>15.5'</td><td>Sand As Above - SAT</td><td></td><td></td><td></td></tr>
7 CONTRACTOR'S OR LANDOWNER'S CERTIFICATION: This water well was constructed, (2) reconstructed, or (3) plugged under my jurisdiction and was completed on (mo/day/year) 6/12/91 and this record is true to the best of my knowledge and belief. Kansas Water Well Contractor's License No. 471 This Water Well Record was completed on (mo/day/yr) 6/14/91 under the business name of HWS Technologies Inc. by (signature)	