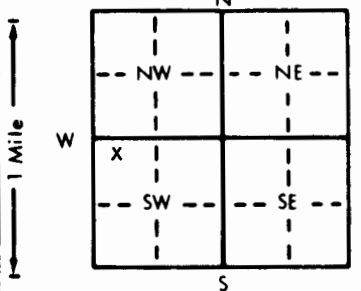


1 LOCATION OF WATER WELL: County: Barton		Fraction NW 1/4 NW 1/4 SW 1/4	Section Number 28	Township Number T 19 S	Range Number R 13 E(W)
Distance and direction from nearest town or city street address of well if located within city? 2537 17th, Great Bend, Kansas					
Job No. 41/4004.01					
2 WATER WELL OWNER: City of Great Bend, KS					
RR#, St. Address, Box # : City, State, ZIP Code : Great Bend, KS 67530					
Board of Agriculture, Division of Water Resources Application Number:					
3 LOCATE WELL'S LOCATION WITH AN "X" IN SECTION BOX: 		4 DEPTH OF COMPLETED WELL: 16 ft. ELEVATION: N/A Depth(s) Groundwater Encountered 1. 10 ft. 2. ft. 3. ft. WELL'S STATIC WATER LEVEL 10.11 ft. below land surface measured on mo/day/yr 6/14/91 Pump test data: Well water was ft. after hours pumping gpm Est. Yield gpm: Well water was ft. after hours pumping gpm Bore Hole Diameter .6.5 in. to 16 ft. and in. to ft. WELL WATER TO BE USED AS: 5 Public water supply 8 Air conditioning 11 Injection well 1 Domestic 3 Feedlot 6 Oil field water supply 9 Dewatering 12 Other (Specify below) 2 Irrigation 4 Industrial 7 Lawn and garden only 10 Monitoring well #8 Was a chemical/bacteriological sample submitted to Department? Yes No X; If yes, mo/day/yr sample was submitted Water Well Disinfected? Yes No X			
5 TYPE OF BLANK CASING USED: 1 Steel 3 RMP (SR) 5 Wrought iron 8 Concrete tile CASING JOINTS: Glued Clamped 2 PVC 4 ABS 6 Asbestos-Cement 9 Other (specify below) Welded 7 Fiberglass Threaded X Blank casing diameter .2 in. to 5.5 ft., Dia in. to ft., Dia in. to ft. Casing height above land surface flush in., weight lbs./ft. Wall thickness or gauge No Sch. 40 TYPE OF SCREEN OR PERFORATION MATERIAL: X PVC 10 Asbestos-cement 1 Steel 3 Stainless steel 5 Fiberglass 8 RMP (SR) 11 Other (specify) 2 Brass 4 Galvanized steel 6 Concrete tile 9 ABS 12 None used (open hole) SCREEN OR PERFORATION OPENINGS ARE: 1 Continuous slot X Mill slot 5 Gauzed wrapped 8 Saw cut 11 None (open hole) 2 Louvered shutter 4 Key punched 6 Wire wrapped 9 Drilled holes 7 Torch cut 10 Other (specify) SCREEN-PERFORATED INTERVALS: From 5.5 ft. to 15.5 ft. From ft. to ft. From ft. to ft. From ft. to ft. GRAVEL PACK INTERVALS: From 3.5 ft. to 16 ft. From ft. to ft. From ft. to ft. From ft. to ft.					
6 GROUT MATERIAL: 1 Neat cement 2 Cement grout X Bentonite 4 Other Grout Intervals: From 1 ft. to 3.5 ft. From ft. to ft. From ft. to ft. What is the nearest source of possible contamination: 1 Septic tank 4 Lateral lines 7 Pit privy 10 Livestock pens 14 Abandoned water well 2 Sewer lines 5 Cess pool 8 Sewage lagoon X Fuel storage 15 Oil well/Gas well 3 Watertight sewer lines 6 Seepage pit 9 Feedyard 12 Fertilizer storage 16 Other (specify below) 13 Insecticide storage Direction from well? West How many feet? 200' FROM TO LITHOLOGIC LOG FROM TO PLUGGING INTERVALS 0 3.0 Silty clay; brown. 3.0 6.0 Silty clay; light brown; mottled brown 6.0 9.5 Silty clay; dark gray, mottled brown; moist. 9.5 11.0 Sand; brown; fine; wet. 11.0 16.0 Sand; brown with pebbles and cobbles; saturated.					
7 CONTRACTOR'S OR LANDOWNER'S CERTIFICATION: This water well was (1) constructed, (2) reconstructed, or (3) plugged under my jurisdiction and was completed on (mo/day/year) 6/12/91 and this record is true to the best of my knowledge and belief. Kansas Water Well Contractor's License No. 471 This Water Well Record was completed on (mo/day/yr) 6/26/91 under the business name of HWS Technologies Inc. by (signature)					