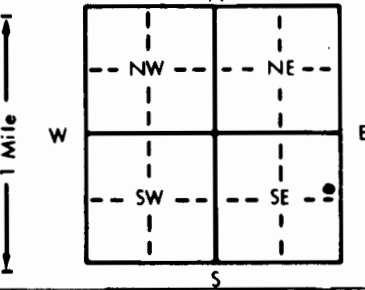


1 LOCATION OF WATER WELL: County: Barton		Fraction SE 1/4 NE 1/4 SE 1/4		Section Number 28		Township Number T 19 S		Range Number R 13 EW																															
Distance and direction from nearest town or city street address of well if located within city? 1400 Broadway Great Bend, KS. 67530																																							
2 WATER WELL OWNER: Hays & Great Bend Fire Extinguisher Co. RR#, St. Address, Box #: 127 E. 8th Hays, Ks. 67601 City, State, ZIP Code: _____						Board of Agriculture, Division of Water Resources Application Number: _____																																	
3 LOCATE WELL'S LOCATION WITH AN "X" IN SECTION BOX: 			4 DEPTH OF COMPLETED WELL 15'6" ft. ELEVATION: _____ Depth(s) Groundwater Encountered 1'6" ft. 2. _____ ft. 3. _____ ft. WELL'S STATIC WATER LEVEL 4.99 ft. below land surface measured on mo/day/yr 2-1-94 Pump test data: Well water was _____ ft. after _____ hours pumping _____ gpm Est. Yield _____ gpm: Well water was _____ ft. after _____ hours pumping _____ gpm Bore Hole Diameter 7'15" in. to 15'6" ft., and _____ in. to _____ ft. WELL WATER TO BE USED AS: 1 Domestic 3 Feedlot 6 Oil field water supply 9 Dewatering 12 Other (Specify below) 2 Irrigation 4 Industrial 7 Lawn and garden only 10 Monitoring well Was a chemical/bacteriological sample submitted to Department? Yes _____ No X ; If yes, mo/day/yr sample was sub- mitted _____ Water Well Disinfected? Yes _____ No X																																				
5 TYPE OF BLANK CASING USED: 1 Steel 3 RMP (SR) 2 PVC 4 ABS Blank casing diameter 2.375 in. to 5' ft., Dia _____ in. to _____ ft., Dia _____ in. to _____ ft. Casing height above land surface Flush Mount in., weight _____ lbs./ft. Wall thickness or gauge No. SDR-13 TYPE OF SCREEN OR PERFORATION MATERIAL: 1 Steel 3 Stainless steel 5 Fiberglass 8 RMP (SR) 2 Brass 4 Galvanized steel 6 Concrete tile 9 ABS SCREEN OR PERFORATION OPENINGS ARE: 1 Continuous slot 3 Mill slot 2 Louvered shutter 4 Key punched SCREEN-PERFORATED INTERVALS: From 15' ft. to 5' ft., From _____ ft. to _____ ft. From _____ ft. to _____ ft., From _____ ft. to _____ ft. GRAVEL PACK INTERVALS: From 15'6" ft. to 4' ft., From _____ ft. to _____ ft. From _____ ft. to _____ ft., From _____ ft. to _____ ft.																																							
6 GROUT MATERIAL: 1 Neat cement 2 Cement grout 3 Bentonite 4 Other Grout Intervals: From 4' ft. to 2' ft., From 2' ft. to 0' ft., From _____ ft. to _____ ft. What is the nearest source of possible contamination: 1 Septic tank 4 Lateral lines 7 Pit privy 11 Fuel storage FOUWER 2 Sewer lines 5 Cess pool 8 Sewage lagoon 12 Fertilizer storage 3 Watertight sewer lines 6 Seepage pit 9 Feedyard 13 Insecticide storage Direction from well? South South East How many feet? 160' <table border="1" style="width:100%; border-collapse: collapse;"> <thead> <tr> <th>FROM</th> <th>TO</th> <th>LITHOLOGIC LOG</th> <th>FROM</th> <th>TO</th> <th>PLUGGING INTERVALS</th> </tr> </thead> <tbody> <tr> <td>0</td> <td>1.50</td> <td>Dk. brown frozen loamy soil, rt. frag., moist.</td> <td></td> <td></td> <td></td> </tr> <tr> <td>1.50</td> <td>5.25</td> <td>Tan brn clay, tight, no odor slight caliche straining, mottled w/ fine grained sand.</td> <td></td> <td></td> <td></td> </tr> <tr> <td>5.25</td> <td>8.75</td> <td>Olive gray silt to sandy silty clay moist to wet fine grained sand.</td> <td></td> <td></td> <td></td> </tr> <tr> <td>8.75</td> <td>15.50</td> <td>Fine-med grained iron stained sand, sorted & graded, wet, no odor.</td> <td></td> <td></td> <td></td> </tr>
7 CONTRACTOR'S OR LANDOWNER'S CERTIFICATION: This water well was (1) constructed , (2) reconstructed, or (3) plugged under my jurisdiction and was completed on (mo/day/year) 2-1-94 and this record is true to the best of my knowledge and belief. Kansas Water Well Contractor's License No. 539 This Water Well Record was completed on (mo/day/yr) 2-21-94 under the business name of JB Environmental Drilling by (signature) James Beber																																							