


1	LOCATION OF WATER WELL: County: Barton	Fraction NE 1/4 SE 1/4 NW 1/4	Section Number 28	Township Number T 19 S	Range Number R 13 E/W
---	---	----------------------------------	----------------------	---------------------------	--------------------------

Distance and direction from nearest town or city street address of well if located within city?
1901 Main St.; Great Bend, Ks.

3 LOCATE WELL'S LOCATION WITH AN "X" IN SECTION BOX: 4 DEPTH OF COMPLETED WELL: 15'6" ft. ELEVATION: 7' ft. 2 ft. 3 ft.

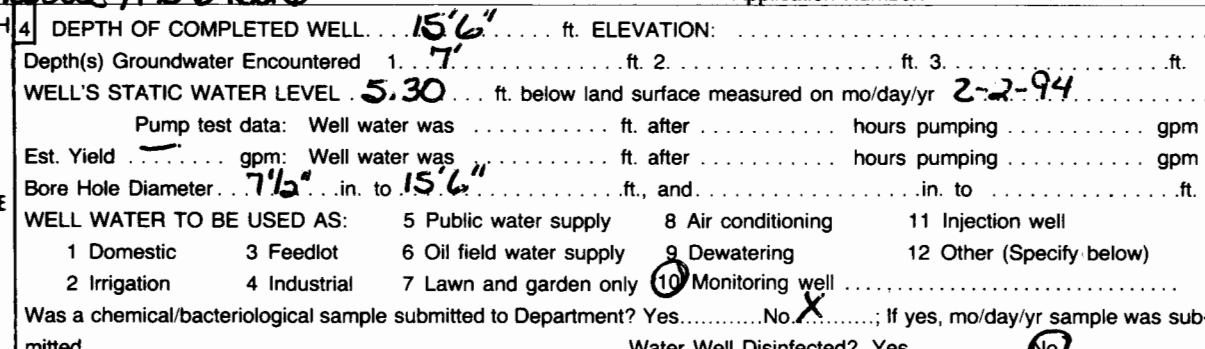

Blank casing diameter 2375 in. to 5' ft. Dia. in. to . ft. Dia. in. to . ft.
Casing height above land surface Flush Mount weight lbs./ft. Wall thickness or gauge No. SOL-13

SCREEN OR PERFORATION OPENINGS ARE:

1 Continuous slot	3 Mill slot	5 Gauzed wrapped	8 Saw cut	11 None (open hole)
2 Louvered shutter	4 Key punched	6 Wire wrapped	9 Drilled holes	
		7 Torch cut	10 Other (specify)	

6] GROUT MATERIAL: 1 Neat cement ② Cement grout ③ Bentonite 4 Other _____
Grout intervals: From 4' ② to 3' ft. From 3' ② ft. to 0' ft. From _____ ft. to _____ ft.

[illegible]

INSTRUCTIONS: Use typewriter or ball point pen. PLEASE PRESS FIRMLY and PRINT clearly. Please fill in blanks, underline or circle the correct answers. Send top three copies to Kansas Department of Health and Environment, Bureau of Water, Topeka, Kansas 66620-0001. Telephone: 913-296-5545. Send one to WATER WELL OWNER and retain one for your records.