

1 LOCATION OF WATER WELL: County: Barton	Fraction NE 1/4 SE 1/4 NW 1/4	Section Number 28	Township Number T 19 S	Range Number R 13 E (W)
---	----------------------------------	----------------------	---------------------------	----------------------------


Distance and direction from nearest town or city street address of well if located within city?

In Great Bend: 1901 Main St: Great Bend, Ks.

2 WATER WELL OWNER: ELA, Inc
RR#, St. Address, Box # : 302 W 4th.
City, State, ZIP Code : Ellinwood, Ks. 67526

Board of Agriculture, Division of Water Resources
Application Number:

3 LOCATE WELL'S LOCATION WITH AN "X" IN SECTION BOX: 4 DEPTH OF COMPLETED WELL: 15' ft. ELEVATION: 15' ft.
Depth(s) Groundwater Encountered: 1 8' # 2 # 3 #

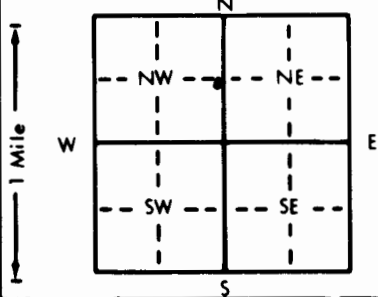

4 DEPTH OF COMPLETED WELL 15' ft. ELEVATION:
Depth(s) Groundwater Encountered 1. 8' ft. 2. ft. 3. ft.
WELL'S STATIC WATER LEVEL 5.25 ft. below land surface measured on mo/day/yr 2-3-94

Pump test data: Well water was ft. after hours pumping gpm
 Est. Yield gpm: Well water was ft. after hours pumping gpm
 Bore Hole Diameter 7 1/2" in. to 15' ft., and in. to ft.

WELL WATER TO BE USED AS:

1 Domestic	3 Feedlot	5 Public water supply	8 Air conditioning	11 Injection well
2 Irrigation	4 Industrial	6 Oil field water supply	9 Dewatering	12 Other (Specify below)
		7 Lawn and garden only	10 Monitoring well	

Was a chemical/bacteriological sample submitted to Department? Yes.....No. X.....; If yes, mo/day/yr sample was submitted
Water Well Disinfected? Yes.....No. No.....

5	TYPE OF BLANK CASING USED:			5 Wrought iron	8 Concrete tile	CASING JOINTS: Glued Clamped Welded Threaded ☒
	1 Steel	3 RMP (SR)	6 Asbestos-Cement	9 Other (specify below)		
	2 PVC	4 ABS	7 Fiberglass			

Blank casing diameter 2.375 in. to 5' ft. Dia. in. to ft. Dia. in. to ft.
Casing height above land surface Flush Mount in. weight lbs./ft. Wall thickness or gauge No. SDR-13

TYPE OF SCREEN OR PERFORATION MATERIAL:				7 PVC	10 Asbestos-cement
1 Steel	3 Stainless steel	5 Fiberglass	8 RMP (SR)	11 Other (specify)	Sch 40
2 Brass	4 Galvanized steel	6 Concrete tile	9 ABS	12 None used (open hole)	

SCREEN OR PERFORATION OPENINGS ARE:

1 Continuous slot	3 Mill slot	5 Gauzed wrapped	8 Saw cut	11 None (open hole)
2 Louvered shutter	4 Key punched	6 Wire wrapped	9 Drilled holes	
		7 Torch cut	10 Other (specify)	

SCREEN-PERFORATED INTERVALS: From 15' ft. to 5' ft., From ft. to ft.
From ft. to ft., From ft. to ft.
GRAVEL PACK INTERVALS: From 15' ft. to 4' ft., From ft. to ft.
From ft. to ft., From ft. to ft.

6 GROUT MATERIAL: 1 Neat cement 2 Cement grout 3 Bentonite 4 Other
Grout Intervals: From 4' ft. to 3' ft., From 3' ft. to 0' ft., From ft. to ft.

What is the nearest source of possible contamination:

1 Septic tank	4 Lateral lines	7 Pit privy	10 Livestock pens	14 Abandoned water well
2 Sewer lines	5 Cess pool	8 Sewage lagoon	11 Fuel storage Fuel	15 Oil well/Gas well
3 Watertight sewer lines	6 Seepage pit	9 Feedyard	12 Fertilizer storage	16 Other (specify below)
			13 Insecticide storage	

Direction from well? South How many feet? 180'

[illegible]

7 CONTRACTOR'S OR LANDOWNER'S CERTIFICATION: This water well was (1) constructed, (2) reconstructed, or (3) plugged under my jurisdiction and was completed on (mo/day/year) 2-3-94 and this record is true to the best of my knowledge and belief. Kansas Water Well Contractor's License No. 539 This Water Well Record was completed on (mo/day/yr) 2-21-94 under the business name of JB Environmental Drilling by (signature) James Bieker