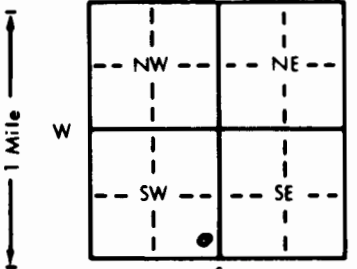


1 LOCATION OF WATER WELL: County: Barton		Fraction SE 1/4 SE 1/4 SW 1/4		Section Number 28		Township Number T 19 S		Range Number R 13 E	
Distance and direction from nearest town or city street address of well if located within city? Great Bend Fire Station, 1205 Williams, Great Bend, Ks.									
2 WATER WELL OWNER: City of Great Bend RR#, St. Address, Box # : 1205 Williams City, State, ZIP Code : Great Bend, Ks. 67530 Board of Agriculture, Division of Water Resources Application Number:									
3 LOCATE WELL'S LOCATION WITH AN "X" IN SECTION BOX: 			4 DEPTH OF COMPLETED WELL: 15'6" ft. ELEVATION: Depth(s) Groundwater Encountered 1. 8' ft. 2. ft. 3. ft. WELL'S STATIC WATER LEVEL 7'6" ft. below land surface measured on mo/day/yr 3-2-94 Pump test data: Well water was ft. after hours pumping gpm Est. Yield gpm: Well water was ft. after hours pumping gpm Bore Hole Diameter 8 1/2" in. to 15'6" ft., and in. to ft. WELL WATER TO BE USED AS: 5 Public water supply 8 Air conditioning 11 Injection well 1 Domestic 3 Feedlot 6 Oil field water supply 9 Dewatering 12 Other (Specify below) 2 Irrigation 4 Industrial 7 Lawn and garden only 10 Monitoring well Was a chemical/bacteriological sample submitted to Department? Yes No X ; If yes, mo/day/yr sample was submitted Water Well Disinfected? Yes No						
5 TYPE OF BLANK CASING USED: 1 Steel 3 RMP (SR) 5 Wrought iron 8 Concrete tile CASING JOINTS: Glued Clamped 2 PVC 4 ABS 6 Asbestos-Cement 9 Other (specify below) Welded Blank casing diameter 2.375 in. to 5' ft., Dia in. to ft., Dia in. to ft. Casing height above land surface Flush in., weight lbs./ft. Wall thickness or gauge No. SDR 13 TYPE OF SCREEN OR PERFORATION MATERIAL: 7 PVC 10 Asbestos-cement SCH 40 1 Steel 3 Stainless steel 5 Fiberglass 8 RMP (SR) 11 Other (specify) 2 Brass 4 Galvanized steel 6 Concrete tile 9 ABS 12 None used (open hole) SCREEN OR PERFORATION OPENINGS ARE: 1 Continuous slot 3 Mill slot 5 Gauzed wrapped 8 Saw cut 11 None (open hole) 2 Louvered shutter 4 Key punched 6 Wire wrapped 9 Drilled holes SCREEN-PERFORATED INTERVALS: From 15' ft. to 5' ft., From ft. to ft. GRAVEL PACK INTERVALS: From 15' ft. to 4' ft., From ft. to ft. From ft. to ft., From ft. to ft.									
6 GROUT MATERIAL: 1 Neat cement 2 Cement grout 3 Bentonite 4 Other Grout Intervals: From 4' ft. to 3' ft., From 3' ft. to 0' ft., From ft. to ft. What is the nearest source of possible contamination: 1 Septic tank 4 Lateral lines 7 Pit privy 11 Fuel storage 14 Abandoned water well 2 Sewer lines 5 Cess pool 8 Sewage lagoon 12 Fertilizer storage 15 Oil well/Gas well 3 Watertight sewer lines 6 Seepage pit 9 Feedyard 13 Insecticide storage 16 Other (specify below) Direction from well? South East How many feet? 150'									
FROM TO		LITHOLOGIC LOG		FROM TO		PLUGGING INTERVALS			
0	2	Dk brn-black silty sandy clay, moist, no odor, fine grained sand.							
2	5	Med tannish brn-yellow brn silty sandy clay to silty sand, moist, no odor.							
5	15'6"	Yellow to grayish sand, moist, no odor. Moist to wet at 8', yellow to gray sand. Strong odor.							
7 CONTRACTOR'S OR LANDOWNER'S CERTIFICATION: This water well was (1) constructed (2) reconstructed, or (3) plugged under my jurisdiction and was completed on (mo/day/year) 3-2-94 and this record is true to the best of my knowledge and belief. Kansas Water Well Contractor's License No. 539 This Water Well Record was completed on (mo/day/yr) 3-13-94 under the business name of JB Environmental Drilling by (signature) James Bieker									