

1 LOCATION OF WATER WELL: Fraction SE 1/4 SE 1/4 SE 1/4 Section Number 29 Township Number T 19 S Range Number R 13 EW  
 County: Barton

Distance and direction from nearest town or city street address of well if located within city?

2716 10th Street

2 WATER WELL OWNER: Gibson-Cell Real Estate

RR#, St. Address, Box # :

1001 Harrison

Board of Agriculture, Division of Water Resources


City, State, ZIP Code :

Great Bend KS 67530

Application Number:

3 LOCATE WELL'S LOCATION WITH AN "X" IN SECTION BOX:

4 DEPTH OF COMPLETED WELL: 14 ft. ELEVATION:

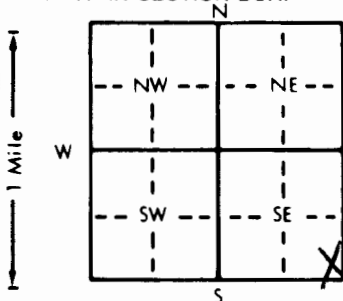

Depth(s) Groundwater Encountered 8.3 ft. 2. ft. 3. ft.

WELL'S STATIC WATER LEVEL 8.3 ft. below land surface measured on mo/day/yr 3-4-93

Pump test data: Well water was ft. after hours pumping gpm

Est. Yield gpm Well water was ft. after hours pumping gpm

Bore Hole Diameter 8 in. to ft. and in. to ft.

WELL WATER TO BE USED AS: 5 Public water supply 8 Air conditioning 11 Injection well

1 Domestic 3 Feedlot 6 Oil field water supply 9 Dewatering 12 Other (Specify below)

2 Irrigation 4 Industrial 7 Lawn and garden only 10 Monitoring well

Was a chemical/bacteriological sample submitted to Department? Yes No X If yes, mo/day/yr sample was submitted Water Well Disinfected? Yes No X

5 TYPE OF BLANK CASING USED:

5 Wrought iron

8 Concrete tile

CASING JOINTS: Glued Clamped

1 Steel

3 RMP (SR)

6 Asbestos-Cement

9 Other (specify below)

Welded

2 PVC

4 ABS

7 Fiberglass

Threaded

Flush

Blank casing diameter in. to ft. Dia in. to ft. Dia in. to ft.

Casing height above land surface Flush in. weight 703 lbs./ft. Wall thickness or gauge No. 154

TYPE OF SCREEN OR PERFORATION MATERIAL:

1 Steel

3 Stainless steel

5 Fiberglass

7 PVC

10 Asbestos-cement

2 Brass

4 Galvanized steel

6 Concrete tile

8 RMP (SR)

11 Other (specify)

9 ABS

12 None used (open hole)

SCREEN OR PERFORATION OPENINGS ARE:

1 Continuous slot

8 Mill slot

5 Gauzed wrapped

8 Saw cut

11 None (open hole)

2 Louvered shutter

4 Key punched

6 Wire wrapped

9 Drilled holes

SCREEN-PERFORATED INTERVALS:

From 4 ft. to 14 ft. From ft. to ft.

From ft. to ft. From ft. to ft.

From ft. to ft. From ft. to ft.

From ft. to ft. From ft. to ft.

GRAVEL PACK INTERVALS:

From 3 ft. to 14 ft. From ft. to ft.

From ft. to ft. From ft. to ft.

6 GROUT MATERIAL:

3 Neat cement

2 Cement grout

3 Bentonite

4 Other

Grout intervals: From 3 ft. to 1 ft. From ft. to ft. From ft. to ft.

What is the nearest source of possible contamination:

1 Septic tank

4 Lateral lines

7 Pit privy

10 Livestock pens

14 Abandoned water well

2 Sewer lines

5 Cess pool

8 Sewage lagoon

11 Fuel storage

15 Oil well/Gas well

3 Watertight sewer lines

6 Seepage pit

9 Feedyard

12 Fertilizer storage

16 Other (specify below)

13 Insecticide storage

Direction from well?

NE

How many feet? 320

| FROM                                                                                             | TO   | LITHOLOGIC LOG              | FROM | TO | PLUGGING INTERVALS |
|--------------------------------------------------------------------------------------------------|------|-----------------------------|------|----|--------------------|
| 0.0                                                                                              | 2.0  | Silt, sandy                 |      |    |                    |
| 2.0                                                                                              | 7.0  | Silt, clayey, sandy         |      |    |                    |
| 7.0                                                                                              | 13.0 | Sand, coarse, poorly sorted |      |    |                    |
| 13.0                                                                                             | 14.0 | Sand & gravel, coarse       |      |    |                    |
| Flush mount waiver granted 12-17-93 for<br>Mid-Town Service, Inc; KDHE 06005576<br>by Don Taylor |      |                             |      |    |                    |

7 CONTRACTOR'S OR LANDOWNER'S CERTIFICATION: This water well was (1) constructed, (2) reconstructed, or (3) plugged under my jurisdiction and was completed on (mo/day/year) 3-4-93 and this record is true to the best of my knowledge and belief. Kansas Water Well Contractor's License No. 531 This Water Well Record was completed on (mo/day/yr) 3-23-93 under the business name of GSI by (signature) Allison Irwin