

1 LOCATION OF WATER WELL: Fraction SE 1/4 SE 1/4 SE 1/4 Section Number 29 Township Number T 19 S Range Number R 13 E/W  
 County: Barton

Distance and direction from nearest town or city street address of well if located within city?


2716 10<sup>1/2</sup> Street

2 WATER WELL OWNER: Gibson-Sell Real Estate  
 RR#, St. Address, Box #: 1001 Harrison  
 City, State, ZIP Code: Great Bend KS 67530

Board of Agriculture, Division of Water Resources  
 Application Number:

3 LOCATE WELL'S LOCATION WITH AN "X" IN SECTION BOX:

4 DEPTH OF COMPLETED WELL: 14 ft. ELEVATION:

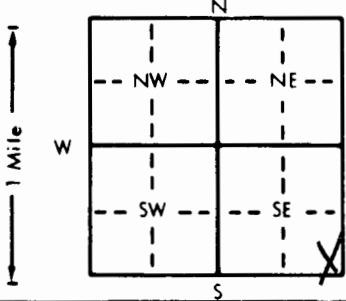

 WELL WATER TO BE USED AS: 5 Public water supply 8 Air conditioning 11 Injection well  
 1 Domestic 3 Feedlot 6 Oil field water supply 9 Dewatering 12 Other (Specify below)  
 2 Irrigation 4 Industrial 7 Lawn and garden only 10 Monitoring well  
 Was a chemical/bacteriological sample submitted to Department? Yes No X If yes, mo/day/yr sample was submitted  
 Water Well Disinfected? Yes No X

5 TYPE OF BLANK CASING USED:

5 Wrought iron 8 Concrete tile CASING JOINTS: Glued Clamped  
 1 Steel 3 RMP (SR) 6 Asbestos-Cement 9 Other (specify below) Welded  
2 PVC 4 ABS 7 Fiberglass Threaded Flush

 TYPE OF SCREEN OR PERFORATION MATERIAL: 7 PVC 10 Asbestos-cement  
 1 Steel 3 Stainless steel 5 Fiberglass 8 RMP (SR) 11 Other (specify)  
 2 Brass 4 Galvanized steel 6 Concrete tile 9 ABS 12 None used (open hole)

SCREEN OR PERFORATION OPENINGS ARE:  
 1 Continuous slot 3 Mill slot 5 Gauzed wrapped 8 Saw cut 11 None (open hole)  
 2 Louvered shutter 4 Key punched 6 Wire wrapped 9 Drilled holes  
 7 Torch cut 10 Other (specify)

SCREEN-PERFORATED INTERVALS: From 4 ft. to 14 ft. From 4 ft. to 14 ft.  
 GRAVEL PACK INTERVALS: From 3 ft. to 14 ft. From 3 ft. to 14 ft.

6 GROUT MATERIAL: 1 Neat cement 2 Cement grout 3 Bentonite 4 Other  
 Grout Intervals: From 3 ft. to 1 ft. From 3 ft. to 1 ft.

What is the nearest source of possible contamination:  
 1 Septic tank 4 Lateral lines 7 Pit privy 11 Fuel storage 14 Abandoned water well  
 2 Sewer lines 5 Cess pool 8 Sewage lagoon 12 Fertilizer storage 15 Oil well/Gas well  
 3 Watertight sewer lines 6 Seepage pit 9 Feedyard 13 Insecticide storage 16 Other (specify below)

Direction from well? NW How many feet? 150

| FROM                                                                                             | TO   | LITHOLOGIC LOG                  | FROM | TO | PLUGGING INTERVALS |
|--------------------------------------------------------------------------------------------------|------|---------------------------------|------|----|--------------------|
| 0.0                                                                                              | 2.0  | Silt, sandy                     |      |    |                    |
| 2.0                                                                                              | 5.0  | Silt, clayey                    |      |    |                    |
| 5.0                                                                                              | 7.0  | Sand, medium grain, well sorted |      |    |                    |
| 7.0                                                                                              | 8.5  | Sand, coarse, scattered gravel  |      |    |                    |
| 8.5                                                                                              | 10.0 | Silty clay                      |      |    |                    |
| 10.0                                                                                             | 14.0 | Sand & gravel                   |      |    |                    |
| Flush maint waiver granted 12-17-93 for<br>Mid-Town Service, Inc; KDAE 06005576<br>By Don Taylor |      |                                 |      |    |                    |

7 CONTRACTOR'S OR LANDOWNER'S CERTIFICATION: This water well was (1) constructed (2) reconstructed, or (3) plugged under my jurisdiction and was completed on (mo/day/year) 3-4-93 and this record is true to the best of my knowledge and belief. Kansas Water Well Contractor's License No. 531 This Water Well Record was completed on (mo/day/yr) 3-23-93 under the business name of GST by (signature) Allison Spurn