

1 LOCATION OF WATER WELL:	Fraction	Section Number	Township Number	Range Number
County: <u>Barton</u>	<u>SE 1/4 SE 1/4 SE 1/4</u>	<u>29</u>	T <u>19</u> S	R <u>13</u> EW


Distance and direction from nearest town or city street address of well if located within city?

2716 10th Street

2 WATER WELL OWNER:	Board of Agriculture, Division of Water Resources
RR#, St. Address, Box # :	Application Number:
City, State, ZIP Code :	

Gibson-Sell Real Estate
1001 Harrison
Great Bend KS 67530

3 LOCATE WELL'S LOCATION WITH AN "X" IN SECTION BOX:	4 DEPTH OF COMPLETED WELL: <u>14</u> ft. ELEVATION:
--	---

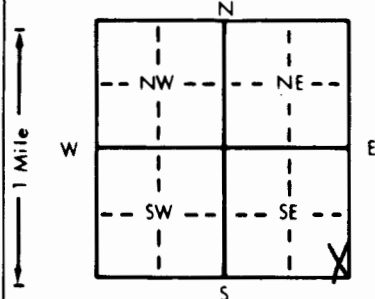

Depth(s) Groundwater Encountered 1 8.5 ft. 2. ft. 3. ft.

WELL'S STATIC WATER LEVEL 8.5 ft. below land surface measured on mo/day/yr 3-4-93

Pump test data: Well water was ft. after hours pumping gpm

Est. Yield gpm: Well water was ft. after hours pumping gpm

Bore Hole Diameter 8 in. to ft. and in. to ft.

WELL WATER TO BE USED AS:

1 Domestic	3 Feedlot	6 Oil field water supply	9 Dewatering	12 Other (Specify below)
2 Irrigation	4 Industrial	7 Lawn and garden only	<u>10 Monitoring well</u>	

Was a chemical/bacteriological sample submitted to Department? Yes No X; If yes, mo/day/yr sample was submitted

Water Well Disinfected? Yes No X

5 TYPE OF BLANK CASING USED:	5 Wrought iron	8 Concrete tile	CASING JOINTS: Glued Clamped
------------------------------	----------------	-----------------	------------------------------

1 Steel	3 RMP (SR)	6 Asbestos-Cement	9 Other (specify below)	Welded
<u>2 PVC</u>	<u>4 ABS</u>	7 Fiberglass		<u>Threaded</u> <u>Flush</u>

Blank casing diameter 2 in. to ft. Dia. in. to ft. Dia. in. to ft.

Casing height above land surface FLUSH in. weight 703 lbs./ft. Wall thickness or gauge No. 154

TYPE OF SCREEN OR PERFORATION MATERIAL:		<u>7 PVC</u>	10 Asbestos-cement
1 Steel	3 Stainless steel	8 RMP (SR)	11 Other (specify)
2 Brass	4 Galvanized steel	9 ABS	12 None used (open hole)

SCREEN OR PERFORATION OPENINGS ARE:		5 Gauzed wrapped	8 Saw cut	11 None (open hole)
1 Continuous slot	<u>3 Mill slot</u>	6 Wire wrapped	9 Drilled holes	
2 Louvered shutter	4 Key punched	7 Torch cut	10 Other (specify)	

SCREEN-PERFORATED INTERVALS:	From <u>4</u> ft. to <u>14</u> ft.	From ft. to ft.	From ft. to ft.
GRAVEL PACK INTERVALS:	From <u>3</u> ft. to <u>14</u> ft.	From ft. to ft.	From ft. to ft.

6 GROUT MATERIAL:	1 Neat cement	2 Cement grout	<u>3 Bentonite</u>	4 Other
-------------------	---------------	----------------	--------------------	---------

Grout Intervals: From 3 ft. to 1 ft. From ft. to ft. From ft. to ft.

What is the nearest source of possible contamination:

1 Septic tank	4 Lateral lines	7 Pit privy	<u>10 Livestock pens</u>	14 Abandoned water well
2 Sewer lines	5 Cess pool	8 Sewage lagoon	<u>11 Fuel storage</u>	15 Oil well/Gas well
3 Watertight sewer lines	6 Seepage pit	9 Feedyard	12 Fertilizer storage	16 Other (specify below)
			13 Insecticide storage	

Direction from well? NE How many feet? 260

FROM	TO	LITHOLOGIC LOG	FROM	TO	PLUGGING INTERVALS
0.0	3.5	Silt, sandy			
3.5	7.0	Sand, medium grain, well sorted			
7.0	13.0	Sand, medium to coarse grain, well sorted			
13.0	14.0	Sand & gravel, coarse			
Flush mount waiver granted 12-17-93 for Mid-Town Services, Inc; KDHE 06005576 by Don Taylor					

7 CONTRACTOR'S OR LANDOWNER'S CERTIFICATION: This water well was <u>(1) constructed</u> , <u>(2) reconstructed</u> , or <u>(3) plugged</u> under my jurisdiction and was completed on (mo/day/year) <u>3-4-93</u> and this record is true to the best of my knowledge and belief. Kansas Water Well Contractor's License No. <u>531</u> This Water Well Record was completed on (mo/day/yr) <u>3-23-93</u> under the business name of <u>GSI</u> by (signature) <u>Allison Irwin</u>
--