USE TYPEWRITER OR BALL POINT PEN-PRESS FIRMLY, PRINT CLEARLY.

WATER WELL RECORD
KSA 82a-1201-1215

Kansas Department of Health and Environment-Division of Environment
(Water well Contractors)
Topeka, Kansas 66620

1. Location of well:	County	Fraction	Section number	Township number	Range number
	Barton	1/4 NW/4 SE 1/4	29	T 19 S	R 13 E/W

2. Distance and direction from nearest town or city: Jefferson
Street address of well location if in city: 1216 ~~Jackson~~

3. Owner of well: Ed Johnson
R.R. or street: 1216 Jefferson
City, state, zip code: Great Bend, K

4. Locate with "X" in section below:

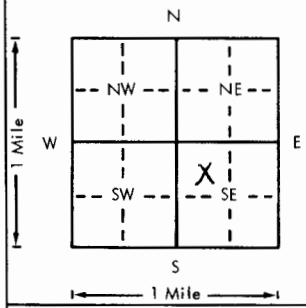

Sketch map:

5. Type and color of material	From	To
Top Soil - Clay	0	11
Sand	11	30
Clay	30	42
Sand - Gravel	42	67

(Use a second sheet if needed)

6. Bore hole dia. 8 in. Completion date
Well depth 67 ft. 3-31-77

7. __ Cable tool X Rotary __ Driven __ Dug
__ Hollow rod __ Jetted __ Bored __ Reverse rotary

8. Use: __ Domestic __ Public supply __ Industry
__ Irrigation __ Air conditioning __ Stock
X Lawn __ Oil field water __ Other

9. Casing: Material
Threaded ___ Welded ___
RMP ___ PVC X
Dia. 5 in. to 67 ft. depth
Dia. ___ in. to ___ ft. depth
Height: Above or below
Surface 12 in.
Weight ___ lbs./ft.
Wall Thickness: inches or gage No. Sch. 40

10. Screen: Manufacturer's name MPI
Type PVC Dia. 5"
Slot/gauze 1/16" Length 20'
Set between 47 ft. and 67 ft.
___ ft. and ___ ft.
Gravel pack? X Size range of material 1/8-3/4"

11. Static water level: 15 ft. below land surface Date 3-31-77 (mo./day/yr.)

12. Pumping level below land surfaces:
___ ft. after ___ hrs. pumping ___ g.p.m.
___ ft. after ___ hrs. pumping ___ g.p.m.
Estimated maximum yield 50 g.p.m.

13. Water sample submitted: mo./day/yr.
__ Yes X No Date

14. Well head completion:
__ Pitless adapter 12 Inches above grade

15. Well grouted? X
With: X Neat cement __ Bentonite __ Concrete
Depth: From 0 ft. to 10 ft.

16. Nearest source of possible contamination: Sewer
ft. 70 Direction N Type
Well disinfected upon completion? X Yes __ No

17. Pump: X Not installed
Manufacturer's name
Model number HP Volts
Length of drop pipe ft. capacity g.p.m.
Type:
__ Submersible __ Turbine
__ Jet __ Reciprocating
__ Centrifugal __ Other

18. Elevation:
Topography:
__ Hill
__ Slope
__ Upland
X Valley

19. Remarks:

20. Water well contractor's certification:
This well was drilled under my jurisdiction and this report is true to the best of my knowledge and belief. 186
Kelly's Waterwell Ser
Business name License No.
Address R2 Great Bend, Ks
Signed Kelly Price Date 7-6-
Authorized representative

T 19 R 13 E/W Sec 29 1/4 NW 1/4 SE 1/4

Forward the white, blue and pink copies to the Department of Health and Environment

Form WWC-5

MI-1023