WATER WELL RECORD Form WWC-5 KSA 82a-1212

1 LOCATION OF WATER WELL:	Fraction	Section Number	Township Number	Range Number
County: Barton	SE ¼ SW ¼ SW ¼	29	T 19 S	R 13 E (W)

Distance and direction from nearest town or city street address of well if located within city?

200' N of the NW corner of Lincoln & 10th Street

2 WATER WELL OWNER: Mr. Joey Zimmerman - Mr. R's 10

RR#, St. Address, Box # : 1906 Main

City, State, ZIP Code : Great Bend, Ks. 67530

Board of Agriculture, Division of Water Resources Application Number:

3 LOCATE WELL'S LOCATION WITH AN "X" IN SECTION BOX:

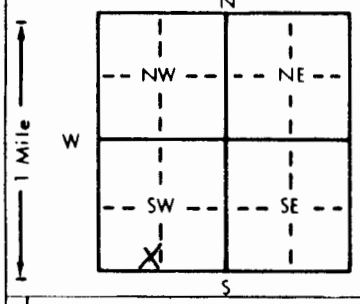

4 DEPTH OF COMPLETED WELL 19 ft. ELEVATION:

Depth(s) Groundwater Encountered 1. 15 ft. 2. ft. 3. ft.

WELL'S STATIC WATER LEVEL 10.64 ft. below land surface measured on mo/day/yr 05-06-94

Pump test data: Well water was ft. after hours pumping gpm

Est. Yield gpm: Well water was ft. after hours pumping gpm

Bore Hole Diameter 7 5/8 in. to 19 ft., and in. to ft.

WELL WATER TO BE USED AS: 5 Public water supply 8 Air conditioning 11 Injection well; 1 Domestic 3 Feedlot 6 Oil field water supply 9 Dewatering 12 Other (Specify below); 2 Irrigation 4 Industrial 7 Lawn and garden only (10) Monitoring well

Was a chemical/bacteriological sample submitted to Department? Yes No X; If yes, mo/day/yr sample was submitted

Water Well Disinfected? Yes No X

5 TYPE OF BLANK CASING USED: 5 Wrought iron 8 Concrete tile; 1 Steel 3 RMP (SR) 6 Asbestos-Cement 9 Other (specify below); 2 PVC 4 ABS 7 Fiberglass

CASING JOINTS: Glued Clamped; Welded; Threaded X

Blank casing diameter 2 in. to 9 ft., Dia in. to ft., Dia in. to ft.

Casing height above land surface 0 in., weight lbs./ft. Wall thickness or gauge No. sch. 40

TYPE OF SCREEN OR PERFORATION MATERIAL: (7) PVC 10 Asbestos-cement; 1 Steel 3 Stainless steel 5 Fiberglass 8 RMP (SR) 11 Other (specify); 2 Brass 4 Galvanized steel 6 Concrete tile 9 ABS 12 None used (open hole)

SCREEN OR PERFORATION OPENINGS ARE: 5 Gauzed wrapped 8 Saw cut 11 None (open hole); 1 Continuous slot (3) Mill slot 6 Wire wrapped 9 Drilled holes; 2 Louvered shutter 4 Key punched 7 Torch cut 10 Other (specify)

SCREEN-PERFORATED INTERVALS: From 9 ft. to 19 ft., From ft. to ft.; From ft. to ft., From ft. to ft.

GRAVEL PACK INTERVALS: From 7 ft. to 19 ft., From ft. to ft.; From ft. to ft., From ft. to ft.

6 GROUT MATERIAL: 1 Neat cement (2) Cement grout (3) Bentonite 4 Other

Grout Intervals: From 0 ft. to 5 ft., From 5 ft. to 7 ft., From ft. to ft.

What is the nearest source of possible contamination: 10 Livestock pens 14 Abandoned water well; 1 Septic tank 4 Lateral lines 7 Pit privy 11 Fuel storage 15 Oil well/Gas well; 2 Sewer lines 5 Cess pool 8 Sewage lagoon 12 Fertilizer storage 16 Other (specify below); 3 Watertight sewer lines 6 Seepage pit 9 Feedyard 13 Insecticide storage

Direction from well? southwest How many feet? 335

FROM	TO	LITHOLOGIC LOG	FROM	TO	PLUGGING INTERVALS
0	3'	cly, v dk brn, sl slty, org rich, med plstc, damp			
3'	6	cly, med brn w/mott gry & rst clr, v slty, tr f-med snd, damp			
6	10	snd, v f-f grnd, sl med c grns, v slty, yell-brn, damp			
10	19	snd, f-c grns, sl-mod grvl, prly srtd, rnd-subang			
					MW5-flush mount cover

7 CONTRACTOR'S OR LANDOWNER'S CERTIFICATION: This water well was (1) constructed, (2) reconstructed, or (3) plugged under my jurisdiction and was completed on (mo/day/year) 04-28-94 and this record is true to the best of my knowledge and belief. Kansas Water Well Contractor's License No. 527 This Water Well Record was completed on (mo/day/yr) 06-09-94 under the business name of GeoCore Services, Inc. by (signature) [signature]

INSTRUCTIONS: Use typewriter or ball point pen. *PLEASE PRESS FIRMLY* and *PRINT* clearly. Please fill in blanks, underline or circle the correct answers. Send top three copies to Kansas Department of Health and Environment, Bureau of Water, Topeka, Kansas 66620-0001. Telephone: 913-296-5545. Send one to WATER WELL OWNER and retain one for your records.