USE TYPEWRITER OR BALL POINT PEN-PRESS FIRMLY, PRINT CLEARLY.

WATER WELL RECORD
KSA 82a-1201-1215

Kansas Department of Health and Environment-Division of Environment
(Water well Contractors)
Topeka, Kansas 66620

1. Location of well:	County	Fraction	Section number	Township number	Range number
	Barton	SE 1/4 SE 1/4 NW 1/4	30	T 19 S	R 13 E W

2. Distance and direction from nearest town or city:

Street address of well location if in city: K-96 Hiway

3. Owner of well: PARK WEST CONDOMINIUMS
R.R. or street:
City, state, zip code: Gt. Bend Kans.

4. Locate with "X" in section below:

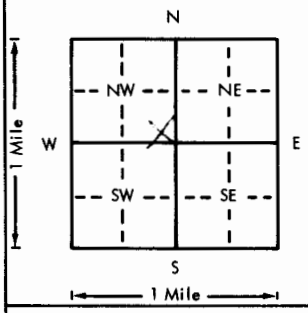

Sketch map:

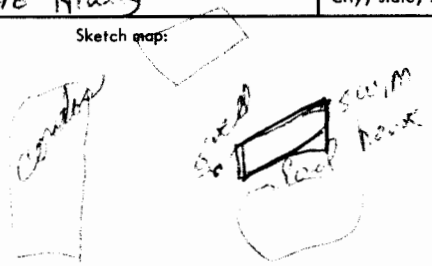

6. Bore hole dia. 9 in. Completion date 2-10-76
Well depth 42 ft.

7. ___ Cable tool X Rotary ___ Driven ___ Dug
___ Hollow rod ___ Jetted ___ Bored ___ Reverse rotary

8. Use: ___ Domestic ___ Public supply ___ Industry
___ Irrigation ___ Air conditioning ___ Stock
X Lawn ___ Oil field water ___ Other

9. Casing: Material PVC Height: Above or below
Threaded ___ Welded X Surface 16 in.
RMP ___ PVC X Weight 200 lbs./ft.
Dia. 5 in. to 42 ft. depth Wall Thickness: inches or
Dia. ___ in. to ___ ft. depth gage No. sch 6

5. Type and color of material	From	To
Top soil	0	6
fine sand	6	30
gravel	30	40
Blue clay	40	42

10. Screen: Manufacturer's name Ft Steel
Type PVC Dia. 5
Slot/gauze .031 Length 10
Set between 30 ft. and 40 ft.
___ ft. and ___ ft.
Gravel pack? X Size range of material 4-12

11. Static water level: mo./day/yr.
20 ft. below land surface Date 9-10-76

12. Pumping level below land surfaces:
30 ft. after 1 hrs. pumping 15 g.p.m.
___ ft. after ___ hrs. pumping ___ g.p.m.
Estimated maximum yield 45 g.p.m.

13. Water sample submitted: mo./day/yr.
___ Yes X No Date ___

14. Well head completion:
X Pitless adapter ___ Inches above grade

15. Well grouted? X
With: ___ Neat cement ___ Bentonite X Concrete
Depth: From 0 ft. to 16 ft.

16. Nearest source of possible contamination: NONE
ft. ___ Direction ___ Type ___
Well disinfected upon completion? ___ Yes ___ No

17. Pump: ___ Not installed
Manufacturer's name Floway
Model number 20FF7 HP 1 Volts 220
Length of drop pipe 32 ft. capacity 45 g.p.m.
Type:
X Submersible ___ Turbine
___ Jet ___ Reciprocating
___ Centrifugal ___ Other

(Use a second sheet if needed)

18. Elevation:

Topography:
___ Hill
___ Slope
X Upland
___ Valley

19. Remarks:

20. Water well contractor's certification:
This well was drilled under my jurisdiction and this report is true to the best of my knowledge and belief.
Lost Water Well Serv. KS
Business name License No.
Address Hwy 40 Hays
Signed [signature] Date 2-10-76
Authorized representative

T 19 R 13 W Sec 30 SE SE NW 1/4 1/4 1/4

Forward the white, blue and pink copies to the Department of Health and Environment

Form WWC-5

MI-1023