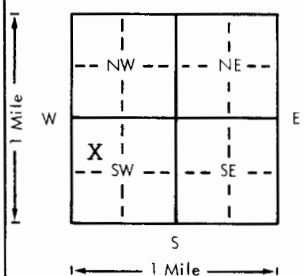


USE TYPEWRITER OR BALL
POINT PEN-PRESS FIRMLY,
PRINT CLEARLY.

WATER WELL RECORD
KSA 82a-1201-1215

Kansas Department of Health and
Environment-Division of Environment
(Water well Contractors)
Topeka, Kansas 66620

1. Location of well:		County Barton	Fraction C 1/4 NW 1/4 SW 1/4	Section number 31	Township number T 19 S R 13 E W	Range number
2. Distance and direction from nearest town or city: 1/2 mile South of Great Bend, KS Street address of well location if in city:				3. Owner of well: Corregan Plumbing & Heating R.R. or street: Box 1127 City, state, zip code: Great Bend, KS 67530		
4. Locate with "X" in section below:		Sketch map:		6. Bore hole dia. 9 in. Completion date 10-4-78 Well depth 60 ft. Pump Set 10-13-78		
				7. ☐ Cable tool ☒ Rotary ☐ Driven ☐ Dug ☐ Hollow rod ☐ Jetted ☐ Bored ☐ Reverse rotary		
5. Type and color of material		From	To	8. Use: ☐ Domestic ☐ Public supply ☐ Industry ☐ Irrigation ☐ Air conditioning ☐ Stock ☐ Lawn ☐ Oil field water ☒ Other TRUCK WASH		
Top soil		0	3	9. Casing: Material Styrene Height: Above or below Threaded ☐ Welded ☒ Surface 12 in. RMP ☐ PVC ☐ Weight 1.5 lbs./ft. Dia. 5 in. to 50 ft. depth; Wall Thickness: inches or Dia. ☐ in. to ☐ ft. depth; gage No. 200		
Brown clay		3	7	10. Screen: Manufacturer's name Jess & Lowell Type Styrene 200 Dia. 5" Slot gauze 1/8" Length 10' Set between 50 ft. and 60 ft. ft. and ☐ ft. Gravel pack? Yes Size range of material 3/8-200		
Sand & gravel		7	25	11. Static water level: 13 ft. below land surface Date 10-4-78 mo./day/yr.		
Brown & yellow clay		25	44	12. Pumping level below land surfaces: Not Checked ft. after ☐ hrs. pumping ☐ g.p.m. ft. after ☐ hrs. pumping ☐ g.p.m. Estimated maximum yield ☐ g.p.m.		
Sand & gravel		44	60	13. Water sample submitted: ☐ Yes ☒ No Date ☐		
				14. Well head completion: ☐ Pitless adapter 12 Inches above grade		
				15. Well grouted? Yes With: ☒ Neat cement ☐ Bentonite ☐ Concrete Depth: From 0 ft. to 10 ft.		
				16. Nearest source of possible contamination: FIELD ft. ☐ Direction ☐ Type ☐ Well disinfected upon completion? ☒ Yes ☐ No		
				17. Pump: ☐ Not installed Manufacturer's name Berkeley Pump Co. Model number 4BM-12 HP 1 1/2 Volts 230 Length of drop pipe 42 ft. capacity 29 g.p.m. Type: ☒ Submersible ☐ Turbine ☐ Jet ☐ Reciprocating ☐ Centrifugal ☐ Other		
				(Use a second sheet if needed)		
18. Elevation:		19. Remarks:		20. Water well contractor's certification: This well was drilled under my jurisdiction and this report is true to the best of my knowledge and belief. Clarke Well & Eq., Inc. 185 Business name License No. Address Great Bend, KS 67530 Signed [Signature] Date 10-17-78 Authorized representative		
Topography: ☐ Hill ☐ Slope ☐ Upland ☐ Valley						

Forward the white, blue and pink copies to the Department of Health and Environment

Form WWC-5