


1 LOCATION OF WATER WELL: County: Barton Fraction: NW 1/4 NW 1/4 NE 1/4 Section Number: 32 Township Number: T 19 S Range Number: R 13 EW

Distance and direction from nearest town or city street address of well if located within city?

3209 W. 10th Street Great Bend

2 WATER WELL OWNER: Ms. Donna Schmidt
RR#, St. Address, Box #: 916 Williams
City, State, ZIP Code: Great Bend KS 67530
Board of Agriculture, Division of Water Resources
Application Number: NA

3 LOCATE WELL'S LOCATION WITH AN "X" IN SECTION BOX: 4 DEPTH OF COMPLETED WELL: 18.0 ft. ELEVATION: NA

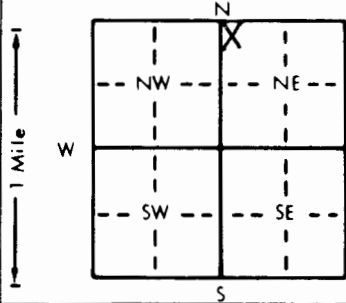

Bore Hole Diameter: 8 in. to 8 ft., and 8 in. to 8 ft.
WELL WATER TO BE USED AS: 5 Public water supply 8 Air conditioning 11 Injection well
1 Domestic 3 Feedlot 6 Oil field water supply 9 Dewatering 12 Other (Specify below)
2 Irrigation 4 Industrial 7 Lawn and garden only 10 Monitoring well
Was a chemical/bacteriological sample submitted to Department? Yes No X If yes, mo/day/yr sample was submitted
Water Well Disinfected? Yes No X

5 TYPE OF BLANK CASING USED: 5 Wrought iron 8 Concrete tile CASING JOINTS: Glued Flush Clamped
1 Steel 3 RMP (SR) 6 Asbestos-Cement 9 Other (specify below) Welded
2 PVC 4 ABS 7 Fiberglass Threaded Flush


TYPE OF SCREEN OR PERFORATION MATERIAL: 1 Steel 3 Stainless steel 5 Fiberglass 8 RMP (SR) 10 Asbestos-cement
2 Brass 4 Galvanized steel 6 Concrete tile 9 ABS 11 Other (specify) 7 PVC
12 None used (open hole)

SCREEN OR PERFORATION OPENINGS ARE: 5 Gauzed wrapped 8 Saw cut 11 None (open hole)
1 Continuous slot 3 Mill slot 6 Wire wrapped 9 Drilled holes
2 Louvered shutter 4 Key punched 7 Torch cut 10 Other (specify)

SCREEN-PERFORATED INTERVALS: From 8.0 ft. to 18.0 ft. From 8.0 ft. to 18.0 ft.
GRAVEL PACK INTERVALS: From 7.0 ft. to 18.0 ft. From 7.0 ft. to 18.0 ft.

6 GROUT MATERIAL: 1 Neat cement 2 Cement grout 3 Bentonite 4 Other
Grout Intervals: From 7.0 ft. to 1.0 ft. From 7.0 ft. to 1.0 ft.

What is the nearest source of possible contamination: 10 Livestock pens 14 Abandoned water well
1 Septic tank 4 Lateral lines 7 Pit privy 11 Fuel storage 15 Oil well/Gas well
2 Sewer lines 5 Cess pool 8 Sewage lagoon 12 Fertilizer storage 16 Other (specify below)
3 Watertight sewer lines 6 Seepage pit 9 Feedyard 13 Insecticide storage

Direction from well? North How many feet? 2

FROM	TO	LITHOLOGIC LOG	FROM	TO	PLUGGING INTERVALS
0.0	5.0	Clayey silt, sand			
5.0	9.0	Sandy silt, coarse sand & some gravel			
9.0	11.0	Sand, coarse, poorly sorted			
11.0	14.5	Clay, silty			
14.5	18.0	Sand, gravel, poorly sorted			
Flush Mount Waiver granted on 10-22-92 for KDHE No. 06005367; Welcome Inns by Don Taylor					

7 CONTRACTOR'S OR LANDOWNER'S CERTIFICATION: This water well was (1) constructed, (2) reconstructed, or (3) plugged under my jurisdiction and was completed on (mo/day/year) 11-20-92 and this record is true to the best of my knowledge and belief. Kansas Water Well Contractor's License No. 531 This Water Well Record was completed on (mo/day/yr) 11-25-92 under the business name of GSI by (signature) Allison Irwin